

SURVEY & REMONUMENTATION

LAND CORNER RECORDATION CERTIFICATE
Filing Requirement of Act 74, Mich. P.A. 1970

NOV 02 1999

For corners in

WASHTENAW
(County)

Located In: SHARDON TOWNSHIP

Corner Code #

SECTION

- 1. Public Land Survey T3S R3E M-6
- T R
- T R
- T R
- T R
- 2. Property Controlling in Section S T R
- S T R
- 3. Miscellaneous Property in Sec. S T R
- S T R

5017317
Page: 1 of 1
02/25/1999 02:59P
Peggy M. Haines - Washtenaw Co. CORREM L-2 P-199

Register of Deeds Stamp & File Number

- 4. Lot No. _____, Recorded Plat _____
- 5. Private Claims _____

I, PAUL V. SCHWIMMER, in a field survey on OCT 28, 19 98 do hereby state that under requirements of P.A. 74, Michigan P.A. of 1970, the corner points mentioned in lines 1 and 2 above were in conformance with regulations and rules therefore as required in the current manual of survey instructions of the United States Department of the Interior, Bureau of Land Management or by a decree of a Court of Law and /or that the corner points mentioned in lines 3, 4 and 5 above were in conformance with the rules of the Michigan Board of Land Surveyors or by a Decree of a Court of Law, established, re-established, monumented, recovered, found as expressed below:

NOTE: Not more than 2 corners, all in the same town and range, may be recorded on this certificate.

A	B	C	D	E	F	G	H	I	J	K	L	M
1												
2	6	5	4	3	2	1						
3												
4	7	8	9	10	11	12						
5												
6	18	17	16	15	14	13						
7												
8	19	20	21	22	23	24						
9												
10	30	29	28	27	26	25						
11												
12	31	32	33	34	35	36						
13												

A. Description of original monument and accessories and/or subsequent restoration:

U.S. GOVERNMENT NOTES (1816) SET 1/4 POST
CYPRESS 14° S 26°E 13 LINKS (1) (GONE)
CYPRESS 9° N 27°E 27 LINKS (2) (GONE)

THERE IS NO EVIDENCE THAT THIS CORNER HAS EVER BEEN RESET.


B. Description of corner evidence found and/or method applied in restoring or reestablishing corner:

I SET THIS CORNER BY SINGLE PROPORTIONAL MEASUREMENT BETWEEN THE S.E. CORNER OF SECTION 13 AND THE N.E. CORNER OF SECTION 13. THE POSITION FELL AT THE WEST EDGE OF AN EXISTING DRAIN. I SET TWO 2" X 18" IRON PIPES, ONE ON TOP OF THE OTHER, WITH THE TOP IRON BEING CAPPED WITH AN ALUMINUM REMONUMENTATION CAP. THERE ARE NO AVAILABLE WITNESSES OF ANY SIZE WITHIN 1000' FEET OF THIS POSITION.

C. Description of monument for corner and accessories established to perpetuate locating the position of the corner:

M-6 EAST 1/4 CORNER OF SECTION 13 SHARDON TOWNSHIP
SET 2" IRON WITH REMONUMENTATION CAP OVER 2" IRON AT THE WATER'S EDGE
N 30°E 26.56' 6' ELM WITH NAIL & REMON. TAG IN S-SIDE
N 65°E 22.12' 12' ELM WITH NAIL & REMON. TAG IN S-SIDE
S 70°E 17.36' 4' ELM WITH NAIL & REMON TAG IN W-SIDE (5)
S 40°E 20.63' 6' ELM WITH NAIL & REMON TAG IN S-SIDE (6)

THE SELECTED LOCATION IS A CAREFUL AND FAITHFUL RE-ESTABLISHMENT OF THE POSITION OF THE ORIGINAL CORNER.

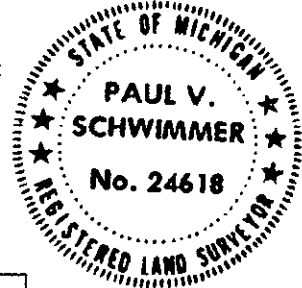

Signed by Paul V. Schwimmer

Date 12-07-1998

COPY

APPROVED
DATE 12-14-98
CO. REP. PK