

SURVEY & REMONUMENTATION

MAY 17 1995

LAND CORNER RECORDATION CERTIFICATE
Filing Requirement of Act 74, Mich. P.A. 1970

For corner on **COMMISSION**
 Washtenaw
 (County)

Located In: Corner Code ##

1. Public Land Survey	T	3S	R	4E	I-10
	T		R		
	T		R		
	T		R		
2. Property Controlling in Section	S		T	R	
	S		T	R	
3. Miscellaneous Property in Sec.	S		T	R	
	S		T	R	

- COPY -
 LIBER 1 PAGE 3Rm
 RECORDED
 WASHTEENAW COUNTY, MI
 SEP 21 11 14 AM '94
 REGGY H. HAINES
 COUNTY CLERK/REGISTER

Register of Deeds Stamp & File Number

4. Lot No. _____, Recorded Plat _____
 5. Private Claims _____

A	B	C	D	E	F	G	H	I	J	K	L	M
2	6	5	4	3	2							
3												
4	7	8	9	10	11	12						
5												
6	18	17	16	15	14	13						
7												
8	19	20	21	22	23	24						
9												
10	30	29	28	27	26	25						
11												
12	31	32	33	34	35	36						
13												

I, Charles C. Wilson, in a field survey on March 25, 1994, do hereby certify that under requirements of P.A. 74, Michigan P.A. of 1970, the corner points mentioned in lines 1 and 2 above were in conformance with regulations and rules therefore as required in the current manual of survey instructions of the United States Department of the Interior, Bureau of Land Management or by a decree of a Court of Law and/or that the corner points mentioned in lines 3, 4 and 5 above were in conformance with the rules of the Michigan Board of Land Surveyors or by a Decree of a Court of Law; established, re-established, monumented, re-monumented, recovered, found as expressed below:

NOTE: Not more than 4 corners, all in the same town and range, may be recorded on this certificate.

A. Description of original monument and accessories and/or subsequent restoration:

United States Government Survey, 1815 Instructions, Surveyed 1819, Bearing Trees Walnut 8" N69deg.W 23 Links(15.18)
 Elm 12" S51deg.E 19 Links(12.54)
 Meas. (N) & (S) 40 Chains(2640)

Washtenaw County Road Commission, William J. Armstrong, PS#2444, June 9, 1939
 Found remains of a very old Wood Stake 40" below ground surface. Reset with a 2" Iron Pipe, Stones & Bricks.
 7" Elm N16-1/2deg.E 83.3 7" Elm N89-1/2deg.E 52.0 Double 4" Elm S59deg.E 29.5
 20" Hickory S21-1/2deg.E 74.8 12" Elm S56deg.W 41.7 14" Ash N82deg.W 75.1

Continued on back:


B. Description of corner evidence found and/or method applied in restoring or reestablishing corner:

Found a 1/2"x12" Iron Pipe at surface of pavement on Schneider Road. Removed and found a 1-1/2" Iron Pipe 12" below pavement surface. I believe this to be in the position of the Iron Pipe set by W.J. Armstrong in 1939 and replaced by R.F. Gutekunst in 1972. Raised the 1-1/2" Iron Pipe with a 1"(ID)x12" Iron Pipe to surface of pavement.

C. Description of monument for corner and accessories established to perpetuate locating the position of the corner:

Corner (I-10) 1" (ID) Iron Pipe with a Remonumentation Cap stamped #13604
 30" Ash N80deg.W 75.0* Conc. Fence Post N85deg.E 26.0(loose)* Petroleum Marker S40deg.W 58.3*
 Petroleum Marker S27deg.E 53.3(N'ly Post)* Railroad Tie Post N45deg.W 48.23(Nail & RT SW/S)
 12" Elm N20deg.E 101.05(Nail & RT W/S) 8" Ash N30deg.E 50.44(Nail & RT W/S)
 10" Elm S85deg.E 37.02(Nail & RT S/S) Center of Pavement 2' W'ly
 Monument Box installed August 8, 1994

* indicates accessory previously mentioned in Paragraph A.
 I find no evidence to conflict with the acceptance of this point as being a careful and faithful perpetuation of the position of the original point.
 This point was ratified by the Washtenaw County Peer Committee on April 5, 1994

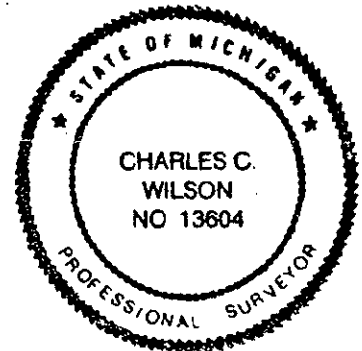

Signed by Charles C. Wilson

Date August 9, 1994

Surveyor's Michigan License No. 13604

LIBER

1 PAGE 4Rm
- COPY -

Paragraph A Continued:

Gutekunst Surveying

Richard E. Gutekunst, PS#7863, April 10, 1972

Found bent 2" Iron Pipe lying near East side of Schneider Road.

Found 2" Hole surrounded by Brick 6" below surface of pavement.

Reset with a 1-1/2" Iron Pipe to 4" below surface of pavement.

Stump N16-1/2deg.E 83.3

Stump N89-1/2deg.E 52.0

20" Hickory S21-1/2deg.E 74.8

Stump S56deg.W 41.7

14" Ash N82deg.W 75.1

Atwell-Hicks, Inc. January 20, 1973

Robert J. Jagow, PS#6998

Found 1-1/2" Iron Pipe in center of pavement

22" Ash N76deg.W 74.7

22" Aspen N8deg.W 74.6

12" Conc Fence Post N85deg.E 25.9

5" Petroleum Marker S28deg.W 58.5

5" Petroleum Marker S27deg.E 53.3

October 13, 1981, Book 799, Page 20

22" Ash N80deg.W 75.0

Conc. Fence Post N85deg.E 25.9

Petroleum Marker S28deg.W 58.5

Petroleum Marker S27deg.E 53.3

Midwestern Consulting, Inc. August 6, 1992

Allen R. Rentschler, PS#15411

Meas. (N) 2680.75

20" Hickory S21deg.E 74.8

14" Ash N82deg.W 75.1

Conc. Post East 25.93

APPROVED

DATE

4/3/94

CO. REP.

A