

REMONUMENTATION

MAY - 1 1995

LAND CORNER RECORDATION CERTIFICATE
Filing Requirement of Act 74, Mich. P.A. 1970

For corners COMMISSION
Washtenaw
(County)

	Located In:	Corner Code #
1. Public Land Survey	T 3S R 4E	1-13
	T _____ R _____	_____
	T _____ R _____	_____
	T _____ R _____	_____
2. Property Controlling in Section	S _____ T _____ R _____	_____
	S _____ T _____ R _____	_____
3. Miscellaneous Property in Sec.	S _____ T _____ R _____	_____
	S _____ T _____ R _____	_____

4. Lot No. _____, Recorded Plat _____
5. Private Claims _____

I, Charles C. Wilson, in a field survey on March 3, 1994, do hereby certify that under requirements of P.A. 74, Michigan P.A. of 1970, the corner points mentioned in lines 1 and 2 above were in conformance with regulations and rules theretore as required in the current manual of survey instructions of the United States Department of the Interior, Bureau of Land Management or by a decree of a Court of Law and/or that the corner points mentioned in lines 3, 4 and 5 above were in conformance with the rules of the Michigan Board of Land Surveyors or by a Decree of a Court of Law; established, re-established, monumented, re-monumented, recovered, found as expressed below:

NOTE: Not more than 4 corners, all in the same town and range, may be recorded on this certificate.

A. Description of original monument and accessories and/or subsequent restoration:

United States Government Survey, 1815 Instructions, Surveyed 1819, Bearing Trees Ash 6" N66deg. W 4 Links(2.64)
Ash 5" S33deg. E 61 links(3.96)
Meas. (N)(E)(W) 40 Chains(2640)

Russell Whipple, County Surveyor 1845 Meas. (N) 40.34 Chains(2662.44)
(E) 40 Chains(2640)

Washtenaw County Road Commission, William J. Armstrong, PS# 2444, August 11, 1933
Found Old Wood Stake. Reset with Iron Pipe, Stones and Bricks

Continued on back:

B. Description of corner evidence found and/or method applied in restoring or reestablishing corner:

Found a 2" Iron Pipe, 3" below gravel road surface on Bemis Road. I believe this to be the point set by William J. Armstrong in 1933. This Iron Pipe corresponds with the remaining accessories in Paragraph A. Placed a 3" Bolt with a RT and Plastic Cap stamped # 13604 in top of 2" Iron Pipe.

C. Description of monument for corner and accessories established to perpetuate locating the position of the corner:

Corner (1-13) 2" Iron Pipe with 3" Bolt, RT and Plastic Cap stamped #13604 in top.
36" W. Oak S46-1/2deg. W 55.05(Nail & RT NW/S)*
8" Basswood S16deg. E 17.43(Nail & RT W/S)*
18" Ash S57deg. E 55.97(Nail & RT NE/S)*
24" Ash S20deg. W 48.38(Nail & RT W/S)
Triple 8"-16" Maple S20deg. W 17.67(Nail & RT W/S)
Twin 8"-14" Basswood S16deg. W 17.34(Nail & RT W/S)


* indicates accessory previously mentioned in Paragraph A.

Continued on back:

- COPY -
1 PAGE 9Rm
RECORDED
WASHTENAW COUNTY, MI
SEP 21 11 24 AM '94
PEGGY M. HARRIS
COUNTY CLERK/REGISTER

Register of Deeds Stamp & File Number

	A	B	C	D	E	F	G	H	I	J	K	L
2	6		5		4		3		2		1	
3												
4	7		8		9		10		11		12	
5												
6	13		17		16		15		14		13	
7												
8	19		20		21		22		23		24	
9												
10	30		29		28		27		26		25	
11												
12	31		32		33		34		35		36	
13												

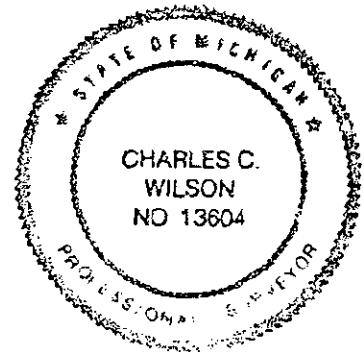

Signed by Charles C. Wilson Date May 1, 1994

Surveyor's Michigan License No. 13604

LIBER

1 PAGE 10RM
-COPY-

A. Paragraph A. Continued:

William J. Armstrong PS# 2444
August 11, 1933
15" S.W. Oak S46-1/2deg. W 55.2
Twin 5" W. Ash N37deg. W 38.9
14" Elm N20-1/2deg. E 102.58
10" B. Cherry N33-1/2deg. E 95.31
8" R. Oak N79deg. E 113.93

Washtenaw Engineering Co., Inc.
Norman N. Fahmer PS# 17620
Act 74 Recordation, Liber 4, Page 272
Found Iron Pipe
30" S.W. Oak S46-1/2deg. W 55.2
25" W. Ash N37deg. W 38.9
24" Ash N45deg. W 33.3
Clump of Maple S10deg. E 17.4(Nail)
Clump of Maple S10deg. W 18.1(Nail)

Washtenaw County Road Commission
Robert A. Campbell Jr. PS# 13028
Act 74 Recordation, Liber 4, Page 375
Found 1-1/4" Iron Pipe
38" W. Oak S46deg. W 55.10(Nail NW/S)
5" Basswood S16deg. E 17.43(Nail W/S)
4" Elm S16deg. W 18.12(Nail E/S)
14" Ash S37deg. E 55.97(Nail NE/S)
Twin 13"-18" Ash N83deg. W 79.24(Nail S/S)

C. Paragraph C. Continued:

I find no evidence to conflict with the acceptance of this found corner
as being a careful and faithful perpetuation of the position of the original corner.

This corner was ratified by the Washtenaw County Peer Committee on March 8, 1994.

APPROVED

DATE 3/8/94
CO. REP. KJ
A