

REMONUMENTATION

MAY - 1 1995

COMMISSION

LAND CORNER RECORDATION CERTIFICATE  
Filing Requirement of Act 74, Mich. P.A. 1970

For corners in  
Washtenaw

(County)

Located In:

Corner Code #

- 1. Public Land Survey T 3S R 4E J-9
- T \_\_\_\_\_ R \_\_\_\_\_
- T \_\_\_\_\_ R \_\_\_\_\_
- T \_\_\_\_\_ R \_\_\_\_\_
- 2. Property Controlling S \_\_\_\_\_ T \_\_\_\_\_ R \_\_\_\_\_
- in Section S \_\_\_\_\_ T \_\_\_\_\_ R \_\_\_\_\_
- 3. Miscellaneous S \_\_\_\_\_ T \_\_\_\_\_ R \_\_\_\_\_
- Property in Sec. S \_\_\_\_\_ T \_\_\_\_\_ R \_\_\_\_\_

- 4. Lot No. \_\_\_\_\_, Recorded Plat \_\_\_\_\_
- 5. Private Claims \_\_\_\_\_

I, Charles C. Wilson, in a field survey on March 26, 1994, do hereby certify that under requirements of P.A. 74, Michigan P.A. of 1970, the corner points mentioned in lines 1 and 2 above were in conformance with regulations and rules therefore as required in the current manual of survey instructions of the United States Department of the Interior, Bureau of Land Management or by a decree of a Court of Law and/or that the corner points mentioned in lines 3, 4 and 5 above were in conformance with the rules of the Michigan Board of Land Surveyors or by a Decree of a Court of Law; established, re-established, monumented, re-monumented, recovered, found as expressed below:

**NOTE: Not more than 4 corners, all in the same town and range, may be recorded on this certificate.**

**A. Description of original monument and accessories and/or subsequent restoration:**

United States Government Survey, 1815 Instructions, Surveyed 1819, Bearing Trees B.O. 12" N44deg.E 18 Links(11.88)  
B.O. 10" S9deg.W 43 Links(28.38)  
Meas. (E) 40 Chains(2640)  
(W) 40 Chains(2640)

Pettibone 18" B. Oak N44-1/2deg.E 78 Links(51.48)  
18" W. Oak N70deg.W 81 Links(53.46)

Continued on back:


**B. Description of corner evidence found and/or method applied in restoring or reestablishing corner:**

Traversed across the North line of Section 26 locating pertinent features. Found Robert G. Macomber's 3/4"x18" Iron Pipe midway and on line between corners (J-9) and (K-9). Although the total measurement did not correspond exactly with the measurement by Macomber in 1981, the Iron Pipe, as found, corresponds with being 1/2 of the total measurement. Searched area around the Iron Pipe for any additional stakes. Found nothing. My calculated 1/4 mile dimensions correspond fairly well with the existing occupation E & W of this corner. I concur with Macomber that this is apparently a lost corner and that the method used to replace this corner in 1981 was proper. I replaced the found 3/4" Iron Pipe with a 1"(ID)x24" Iron Pipe with a Remonumentation Cap stamped # 13604.

**C. Description of monument for corner and accessories established to perpetuate locating the position of the corner:**

Corner (J-9) 1"(ID)x24" Iron Pipe with a Remonumentation Cap stamped # 13604

Continued on back:

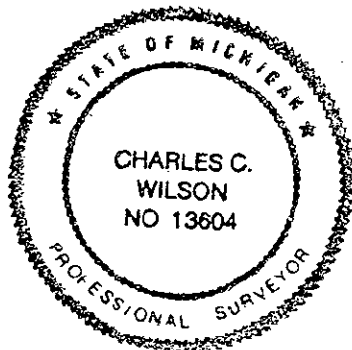

Signed by Charles C. Wilson

Date May 1, 1994

Surveyor's Michigan License No. 13604

RECORDED  
 WASHTENAW COUNTY, MI  
 SEP 21 11 24 AM '94  
 PEGGY M. HAINES  
 COUNTY CLERK/REGISTER

LIBER 1 PAGE 11Rm  
 COPY - Register of Deeds Stamp & File Number

	A	B	C	D	E	F	G	H	I	J	K	L
2	6		5		4		3		2		1	
3												
4	7		8		9		10		11		12	
5												
6	18		17		16		15		14		13	
7												
8	19		20		21		22		23		24	
9												
10	30		29		28		27		26		25	
11												
12	31		32		33		34		35		36	
13												

A. Paragraph A. Continued:

LIBER

1 PAGE 12 Rm  
-COPY-

Atwell-Hicks, Inc.

Robert G. Macomber, PS# 27453

Act 74 Recordation, Liber 6, Page 176

Found no evidence of corner or previous accessories

Set 3/4" Iron Pipe midway and on line between corners (I-9) & (K-9)

20" B. Oak S20deg.W 9.0

22" B. Oak N80deg.E 26.3

12" Shagbark Hickory S10deg.E 47.7

On range of Fence S'y

Concrete Cylinder S10deg.E 18.1

C. Paragraph C. Continued:

24" B. Oak S20deg.W 9.05(Nail & RT W/S)

28" B. Oak N80deg.E 25.88(Nail & RT N/S)

14" Shagbark Hickory S10deg.E 47.25(Nail & RT E/S)

E-W Fence S'y 18'

On range of Fence S'y

Concrete Cylinder S10deg.E 17.8

20" Oak S45deg.W 36.28(Nail & RT NW/S)

8" Elm N80deg.W 29.70(Nail & RT N/S)

22" Oak N30deg.E 43.42(Nail & RT W/S)

Stump N20deg.W 20.0

Stump N40deg.W 43.4

I find no evidence to conflict with the acceptance of this corner as being the proper replacement of the position of the original corner.

This corner was ratified by the Washtenaw County Peer Committee on April 5, 1994

APPROVED

DATE 4/5/94

CO. REP. K

A