

Survey &
REMONUMENTATION

MAY - 1 1995

LAND CORNER RECORDATION CERTIFICATE
Filing Requirement of Act 74, Mich. P.A. 1970

For corners in COMMISSION
Washtenaw

(County)	Located In:	Corner Code #
1. Public Land Survey	T 3S R 4E	K-9
	T _____ R _____	_____
	T _____ R _____	_____
	T _____ R _____	_____
2. Property Controlling in Section	S _____ T _____ R _____	_____
	S _____ T _____ R _____	_____
3. Miscellaneous Property in Sec.	S _____ T _____ R _____	_____
	S _____ T _____ R _____	_____
4. Lot No. _____, Recorded Plat _____		
5. Private Claims _____		

RECORDED
 WASHTENAW COUNTY, MI
 SEP 21 11 15 AM '94
 PEGGY M. HAINES
 COUNTY CLERK/REGISTER
 LIBER 1 PAGE 15Rm
 -COPY-
 Register of Deeds Stamp & File Number

I, Charles C. Wilson, in a field survey on March 25, 1994, do hereby certify that under requirements of P.A. 74, Michigan P.A. of 1970, the corner points mentioned in lines 1 and 2 above were in conformance with regulations and rules therefore as required in the current manual of survey instructions of the United States Department of the Interior, Bureau of Land Management or by a decree of a Court of Law and/or that the corner points mentioned in lines 3, 4 and 5 above were in conformance with the rules of the Michigan Board of Land Surveyors or by a Decree of a Court of Law; established, re-established, monumented, re-monumented, recovered, found as expressed below:

NOTE: Not more than 4 corners, all in the same town and range, may be recorded on this certificate.

	A	B	C	D	E	F	G	H	I	J	K	L
2	6		5		4		3		2		1	
3												
4	7		8		9		10		11		12	
5												
6	18		17		16		15		14		13	
7												
8	19		20		21		22		23		24	
9												
10	30		29		28		27		26		25	
11												
12	31		32		33		34		35		36	
13												

A. Description of original monument and accessories and/or subsequent restoration:

United States Government Survey, 1815 Instructions, Surveyed 1819, Bearing Trees
 W.O. 14" N60deg.E 46 Links(30.46)
 B.O. 15" S70deg.W 41 Links(27.06)
 Meas. (N)(S) & (W) 40 Chains(2640)
 Meas. (E) 39.5 Chains(2607)
 Russel Whipple, County Surveyor 1840
 1842 Meas. (S) 40.47 Chains(2671.02)
 Meas. (S) 40.5 Chains(2673)
 Washtenaw County Road Commission, William J. Armstrong, PS#2444, September 13, 1935
 Surveyed and set an Iron Pipe Stones and Bricks
 12" B. Cherry N44deg.E 34.8 4" W. Oak S17deg.W 83.7 12" B. Cherry S88deg.W 34.9 or 35.5
 3 light of Way Iron Pipes (W)(NE)(SE)


Continued on back:

B. Description of corner evidence found and/or method applied in restoring or reestablishing corner:

Found a 1"(OD)x18" Iron Pipe with aluminum cap at the intersection of Steinbach Road with Textile Road. Removed this Iron Pipe and found a 1-1/4" Iron Pipe with traces of brick chips. This is typical of Armstrong and I accept tis Iron Pipe as being the one he placed in 1935. I set a 1"(ID)x16" Iron Pipe to surface of pavement and set Remonumentation Cap stamped #13604 on top.

C. Description of monument for corner and accessories established to perpetuate locating the position of the corner:

Corner (K-9) 1"(ID) Iron Pipe with Remonumentation Cap stamped #13604
 12" Steel Post S62deg.W 99.8 to center* Utility Pole N35deg.E 53.56(Nail & RT NW/S)
 24" Hickory(dead) W'ly 118.43(Nail & RT S/S) 12" Steel Post S86deg.W 89.1 to center
 S'ly end of 24" CMP S35deg.E 36.65 to center S'ly end of 24" CMP S20deg.W 60.95 to center
 Monument Box installed August 5, 1994
 *indicates accessory previously mentioned in Paragraph A.
 I find no evidence to conflict with the acceptance of this corner as the best available evidence of the position of the original corner.
 This corner was ratified by the Washtenaw County Peer Committee April 5, 1994

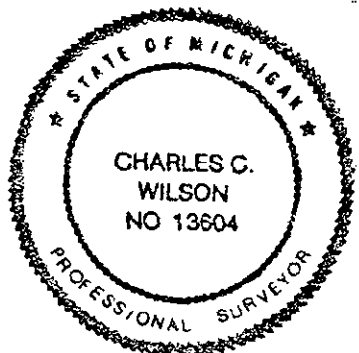

Signed by Charles C. Wilson Date May 1, 1994

Surveyor's Michigan License No. 13604

LASER

1 PAGE 16Rm
-COPY-

Paragraph A. Continued:

Midwestern Consulting, Inc. October 30, 1981
Allen R. Rentschler, PS#15411
Found 1" Iron Pipe
14" Cherry W'ly 35.2
10" Steel Post S40deg. W 99.8
Power Pole N25deg. E 47.2

Washenaw County Road Commission May 14, 1987
Meas. (S) 2688.81

APPROVED

DATE 4/5/94

CO. REP. KA

4