

REMONUMENTATION

MAY - 1 1995

LAND CORNER RECORDATION CERTIFICATE
Filing Requirement of Act 74, Mich. P.A. 1970

For corners in **COMMISSION**
Washtenaw

(County)	Located In:	Corner Code #
1. Public Land Survey	T <u>3S</u> R <u>4E</u>	<u>K-13</u>
	T _____ R _____	_____
	T _____ R _____	_____
	T _____ R _____	_____
2. Property Controlling in Section	S _____ T _____ R _____	_____
	S _____ T _____ R _____	_____
3. Miscellaneous Property in Sec.	S _____ T _____ R _____	_____
	S _____ T _____ R _____	_____

RECORDED
 WASHTENAW COUNTY, MI
 SEP 21 11 16 AM '94
 PEGGY H. HAINES
 COUNTY CLERK/REGISTER
 COPY
 1 PAGE
 23Rm
 Register of Deeds Stamp & File Number

4. Lot No. _____, Recorded Plat _____
 5. Private Claims _____

I, Charles C. Wilson, in a field survey on March 3, 1994, do hereby certify that under requirements of P.A. 74, Michigan P.A. of 1970, the corner points mentioned in lines 1 and 2 above were in conformance with regulations and rules therefore as required in the current manual of survey instructions of the United States Department of the Interior, Bureau of Land Management or by a decree of a Court of Law and/or that the corner points mentioned in lines 3, 4 and 5 above were in conformance with the rules of the Michigan Board of Land Surveyors or by a Decree of a Court of Law; established, re-established, monumented, re-monumented, recovered, found as expressed below:

NOTE: Not more than 4 corners, all in the same town and range, may be recorded on this certificate.

	A	B	C	D	E	F	G	H	I	J	K	L
2	6	5	4	3	2	1						
3												
4	7	8	9	10	11	12						
5												
6	18	17	16	15	14	13						
7												
8	19	20	21	22	23	24						
9												
10	30	29	28	27	26	25						
11												
12	31	32	33	34	35	36						
13												

A. Description of original monument and accessories and/or subsequent restoration:

United States Government Survey, 1815 Instructions, Surveyed 1819, Bearing Trees None Available
 Meas. (N)(E)(W) 40 Chains(2640)
 Washtenaw Engineering Co., Inc., September 1, 1967
 Allen R. Rentschler PS# 15411
 Found Iron Pipe at Fence Intersection
 24" Stump S50deg. E 6.5
 24" Maple S50deg. W 37.0


B. Description of corner evidence found and/or method applied in restoring or reestablishing corner:

Found a 1-1/8"(OD) - 3/4"(ID) Iron Pipe which corresponds with the accessory witnesses taken by Mr. Rentschler in 1967. As this point may be suspect, we traverse around the South 1/2 of Section 35 and the Southwest 1/4 of Section 36. Traverse Closure is 1/90,000. Calculations indicate that this Iron Pipe is on a straight line connecting corners I-13 & L-13. Distance between I-13 & L-13 calculates to be 7940.38, which divided by 3 indicates a dimension of 2646.793 for each 40 chains. The Iron Pipe, as found, is 2651.96 feet West of corner I-13. The Iron Pipe is in an area of marsh and a search of the area 5'+ East of the Iron Pipe discloses nothing. I feel that because the Iron Pipe, as found, is in close proximity to the location of a straight proportion and that it is in correspondence with the existing occupational evidence, that it should be accepted as an adequate replacement of the position of the original corner.

C. Description of monument for corner and accessories established to perpetuate locating the position of the corner:

Corner (K-13) Reset the found Iron Pipe with a 1"(ID)x48" Iron Pipe with a Remonumentation Cap stampes #13604

Continued on back:

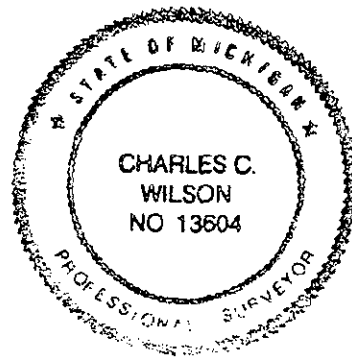

Signed by Charles C. Wilson Date May 1, 1994

Surveyor's Michigan License No. 13604

LIBER

1 PAGE 24RM
COPY

Paragraph C. Continued:

Corner (I-13) 1"x48" Iron Pipe with a Remonumentation Cap stamped #13604
Stump S50deg. E 6.5
Stump S50deg. W 37.0
Twin 6"-8" Ash N3deg. E 23.75(Nail & RT S/S)
10" Maple S45deg. E 21.86(Nail & RT SW/S)
8" Maple S25deg. E 34.97(Nail & RT SW/S)
12" Maple S80deg. W 25.08(Nail & RT SW/S)
36" Maple N50deg. W 28.47(Nail & RT NE/S)
10" Maple W'y 36.46(Nail & RT S/S)
24" Maple N45deg. E 21.58(Nail & RT E/S)

This corner was ratified by the Washtenaw County Peer Committee on March 8, 1994

APPROVED

DATE 3/8/94

CO. REP. MA