

MAY - 1 1995

COMMISSION

LAND CORNER RECORDATION CERTIFICATE

Filing Requirement of Act 74, Mich. P.A. 1970

For corners in Washtenaw

(County)

Located In:

Corner Code #/

1. Public Land Survey	T 3S R 4E	L-9
	T R	
	T R	
	T R	
2. Property Controlling in Section	S T R	
	S T R	
3. Miscellaneous Property in Sec.	S T R	
	S T R	

RECORDED
 WASHTENAW COUNTY, MI
 SEP 21 11 16 AM '94
 PEGGY H. HAINES
 COUNTY CLERK/REGISTRAR
 COPY

LIBER 1 PAGE 25Rm
 - COPY -
 Register of Deeds Stamp & File Number

- 4. Lot No. _____, Recorded Plat _____
- 5. Private Claims _____

I, Charles C. Wilson, in a field survey on March 22, 1994, do hereby certify that under requirements of P.A. 74, Michigan P.A. of 1970, the corner points mentioned in lines 1 and 2 above were in conformance with regulations and rules therefore as required in the current manual of survey instructions of the United States Department of the Interior, Bureau of Land Management or by a decree of a Court of Law and/or that the corner points mentioned in lines 3, 4 and 5 above were in conformance with the rules of the Michigan Board of Land Surveyors or by a Decree of a Court of Law; established, re-established, monumented, re-monumented, recovered, found as expressed below:

NOTE: Not more than 4 corners, all in the same town and range, may be recorded on this certificate.

A. Description of original monument and accessories and/or subsequent restoration:

United States Government Survey, 1815 Instructions, Surveyed 1819. Bearing Trees W.O. 24" N50deg. W 50 Links(33.0)
 W.O. 18" S89deg. E 48 Links(31.68)
 Meas. (L) 39.5 Chains(2607)
 (W) 39.5 Chains(2607)

Washtenaw County Road Commission, William J. Armstrong, PS# 2444, October 11, 1935
 Surveyed and set a standard 4"x48" Concrete Monument. Stones and Bricks.

Continued on back:

B. Description of corner evidence found and/or method applied in restoring or reestablishing corner:


Found a Concrete Monument with a 1-1/4"(OD) Iron Pipe in center. Point is 5" below Gravel Surface on Textile Road. Broken pieces of brick are evident. This point corresponds with accessories mentioned in Paragraph A. Set a 3" Bolt, RT and Plastic Cap stamped # 13604 in top of Monument.

C. Description of monument for corner and accessories established to perpetuate locating the position of the corner:

Corner (L-9), 4" Concrete Monument with 1-1/4"(OD) Iron Pipe in center.
 Raised with 3" Bolt, RT and Plastic Cap stamped # 13604
 21' W'ly of range of fence S'ly* 20" W. Oak N2deg. W 47.98(Nail & RT E/S)*
 24" W. Oak N34deg. E 42.00(Nail & RT E/S)* 18" W. Oak N38deg. E 46.40(Nail & RT SE/S)*
 14" Hickory N54deg. E 58.20(Nail & RT NW/S)* 18" Pear S87deg. W 160.0(Nail & RT N/S)*
 22" Hickory N76deg. W 121.80(Nail & RT N/S)* 20" Hickory N60deg. W 104.52(Nail SW/S)
 Iron Ppe N'ly 33.02

* indicates accessory previously mentioned in Paragraph A.

Continued on back:

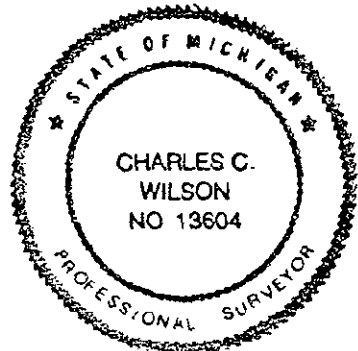

Signed by Charles C. Wilson

Date May 1, 1994

Surveyor's Michigan License No. 13604

A. Paragraph A. Continued:

William J. Armstrong, PS# 2444
October 11, 1935
21.0 W. of range of fence S'y
12" W. Oak N2deg.W 48.5
24" B. Oak N. 32.4
10" Hickory N8deg.E 27.7
14" W. Oak N34deg.E 42.0
12" W. Oak N38-1/2deg.E 46.4
6" Hickory N54deg.E 58.2
6" Pear S87-1/2deg.W 160.8
10" Hickory N76deg.W 121.8

Washenaw Engineering Co., Inc.
Norman N. Fahrner, PS# 17620
Act 74 Recordation, Liber 1, Page 19
Found 1 1/2" Iron Pipe from 1935 accessories
21" W. of range of fence S'y
26" Oak North 31.6
12" Pear S87-1/2deg.W 160.8

C. Wilson & Associates, Inc.
Charles C. Wilson, PS# 13604
Survey
Found Concrete Monument
16" W. Oak N2deg.W 48.5
20" W. Oak N34deg.E 42.0
16" W. Oak N38-1/2deg.E 46.4
12" Hickory N54deg.E 58.2
16" Hickory N76deg.W 121.8

LIBER

1 PAGE 26Rm
-COPY-

C. Paragraph C. Continued:

I find no evidence to conflict with the acceptance of this found corner
as being a careful and faithful perpetuation of the position of the original corner.

This corner was ratified by the Washenaw County Peer Committee on April 5, 1994

APPROVED

DATE 4/5/94

CO. REP. K/A