

REMONUMENTATION

MAY - 1 1995

COMMISSION

LAND CORNER RECORDATION CERTIFICATE
Filing Requirement of Act 74, Mich. P.A. 1970

For corners in
Washtenaw

(County)	Located In:	Corner Code #
1. Public Land Survey	T 3S R 4E	L-11
	T R	
	T R	
	T R	
2. Property Controlling in Section	S T R	
	S T R	
3. Miscellaneous Property in Sec.	S T R	
	S T R	

RECORDED
 WASHTENAW COUNTY, MI
 SEP 21 11 16 AM '94
 PEGGY R. HAINES
 COUNTY CLERK/REGISTER

1 PAGE 27Rm
 - COPY -
 Register of Deeds Stamp & File Number

4. Lot No. _____, Recorded Plat _____
 5. Private Claims _____

	A	B	C	D	E	F	G	H	I	J	K	L
2	6	5	4	3	2	1						
3												
4	7	8	9	10	11	12						
5												
6	18	17	16	15	14	13						
7												
8	19	20	21	22	23	24						
9												
10	30	29	28	27	26	25						
11												
12	31	32	33	34	35	36						
13												

I, Charles C. Wilson, in a field survey on September 1, 1993, do hereby certify that under requirements of P.A. 74, Michigan P.A. of 1970, the corner points mentioned in lines 1 and 2 above were in conformance with regulations and rules therefore as required in the current manual of survey instructions of the United States Department of the Interior, Bureau of Land Management or by a decree of a Court of Law and/or that the corner points mentioned in lines 3, 4 and 5 above were in conformance with the rules of the Michigan Board of Land Surveyors or by a Decree of a Court of Law; established, re-established, monumented, re-monumented, recovered, found as expressed below:

NOTE: Not more than 4 corners, all in the same town and range, may be recorded on this certificate.

A. Description of original monument and accessories and/or subsequent restoration:

United States Government Survey, 1815 Instructions, Surveyed 1819, Bearing Trees B.O. 15° S26deg.E 26 Links(17.16)
 B.O. 17° N11deg.E 29 Links(19.14)

Washtenaw County Road Commission, William J. Armstrong PS# 2444 October 12, 1933
 Found Plow Point, Wood Stake and Stones. Reset with Iron Pipe Stones and Bricks

Continued on back:

B. Description of corner evidence found and/or method applied in restoring or reestablishing corner:

Found a 1-1/2"(OD) - 1-1/4"(ID) Iron Pipe and traces of Brick Chips on North edge of Gravel Surface for Bethel Church Road and 5" below Gravel Surface. Although the Accessory Witnesses, taken by Mr. Armstrong in 1933, are no longer available, I believe this Iron Pipe, as found, to be typical of Mr. Armstrong, and Brick Chips were still in evidence.


C. Description of monument for corner and accessories established to perpetuate locating the position of the corner:

Corner (L-11) 1-1/4"(ID) Iron Pipe, as found, with a Remonumentation Cap stamped #13604 on top
 20" Walnut S50deg.W 37.80 to Nail & RT (NW/S)*
 Pinch Top Iron Pipe N'y 33.0*
 Twin 15" Oak N85deg.W 22.46 to Nail & RT (S/S)*
 Twin 6"-10" Walnut S45deg.E 45.73 to Nail & RT (NE/S)*
 Power Pole N10deg.W 31.52 to Nail & RT (E/S)*

* indicates accessory previously mentioned in Paragraph A.

I find no evidence to conflict with the acceptance of this found corner as being a careful and faithful perpetuation of the position of the original corner.

This corner was ratified by the Washtenaw County Peer Committee on March 8, 1994

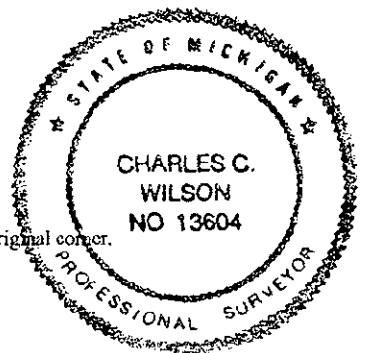

Signed by Charles C. Wilson Date May 1, 1994

Surveyor's Michigan License No. 13604

LIBER

1 PAGE 28 Rm
-COPY-

A. Paragraph A. Continued:

William J. Armstrong PS# 2444, October 12, 1933
10" Hickory N23deg. W 46.3
10" Hickory N5deg. W 36.6
20" Apple S2deg. E 34.8
16" Apple S41deg. W 79.5
12" Apple S53deg. W 65.1

Unknown Origin and Date
8" Walnut S35deg. W 37.5
15" Catalpa S'y 63.3
Iron Pipes N'y & S'y 33'

Washtenaw Engineering Co., Inc., October 10, 1985
Norman N. Fahrner PS# 17620
Found 2" Iron Pipe
8" Walnut S50deg. W 37.25 to Nail
Twin 12" Oak N85deg. W 22.20 to Nail
Twin 6" Walnut S45deg. E 45.73 to Nail
Power Pole North 31.65 to Nail

APPROVED

DATE 3/8/94

CO. REP. K_A