SURVEY &
REMONUMENTATION

MAY 0 3 1995

COMMISSION

LAND CORNER RECORDATION CERTIFICATE
Filing Requirement of Act 74, Mich. P.A. 1970

For corners in Washtenaw (County)

	Located In:	Corner Code #:
1. Public Land Survey	T 3S R 4E	L-13
	T ___ R ___	
	T ___ R ___	
	T ___ R ___	Seg. 1
2. Property Controlling	S ___ T ___ R ___	
in Section	S ___ T ___ R ___	
3. Miscellaneous	S ___ T ___ R ___	
Property in Sec.	S ___ T ___ R ___	

RECORDED WASHTENAW COUNTY, MI
SEP 21 11 16 AM '94
PEGGY H. HAINES COUNTY CLERK/REGISTER
Copy
LIBER 1 PAGE 29Rm
-COPY-
Register of Deeds Stamp & File Number

4. Lot No. _____ , Recorded Plat _____
5. Private Claims _____

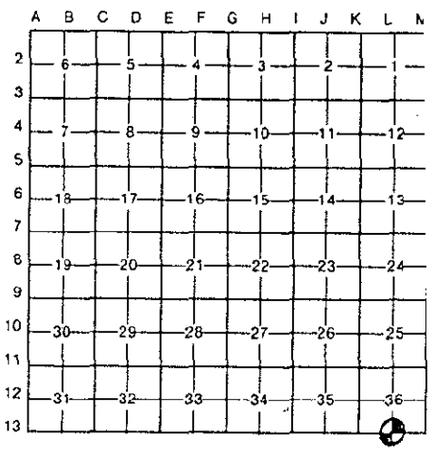

I, Charles C. Wilson, in a field survey on September 1, 19 93, do hereby certify that under requirements of P.A. 74, Michigan P.A. of 1970, the corner points mentioned in lines 1 and 2 above were in conformance with regulations and rules therefore as required in the current manual of survey instructions of the United States Department of the Interior, Bureau of Land Management or by a decree of a Court of Law and/or that the corner points mentioned in lines 3, 4 and 5 above were in conformance with the rules of the Michigan Board of Land Surveyors or by a Decree of a Court of Law; established, re-established, monumented, re-monumented, recovered, found as expressed below:

NOTE: Not more than 4 corners, all in the same town and range, may be recorded on this certificate.

A. Description of original monument and accessories and/or subsequent restoration:

United States Government Survey, 1815 Instructions. Surveyed 1819, Bearing Trees: B.O. 14" N5deg.W 12 Links(7.92)
Hickory 16" S10deg.W 10 Links(6.6)
Meas. (E)(W) 40 Chains(2640)

Washtenaw County Road Commission, William J. Armstrong PS# 2444, July 17, 1940
Found Old Wood Stake and Stones. Reset with a 1-1/2"x36" Iron Pipe Stones & Bricks

Meas. East (2668.7) Meas. North (2739.0)

Continued on back:

B. Description of corner evidence found and/or method applied in restoring or reestablishing corner:

Found a 1-1/4"(OD) - 1"(ID) Iron Pipe extending 1' above ground surface and 1' N'ly of E-W Fence.
This point, as found, agrees with remaining accessories mentioned in Paragraph A. I believe this Iron Pipe to be the point set by Mr. Armstrong in 1940.

C. Description of monument for corner and accessories established to perpetuate locating the position of the corner:

Corner (L-13) 1" (ID) Iron Pipe, as found, with a Remonumentation Cap stamped #13604 on top

I find no evidence to conplict with the acceptance of this found corner as being a careful and faithful perpetuation of the position of the original corner.

This corner was ratified by the Washtenaw County Peer Committee on March 3, 1994

Continued on back:

STATE OF MICHIGAN
CHARLES C. WILSON
NO 13604
PROFESSIONAL SURVEYOR

Signed by Charles C. Wilson Date May 1, 1994

Surveyor's Michigan License No. 13604

FORM APPROVED BY MICHIGAN STATE BOARD OF LAND SURVEYORS, JAN. 28, 1971
REVISED MAY 14, 1975
REVISED JAN., 1983