

MAR 09 1998

SECTION

RECORDED
WASHTENAW COUNTY, MI

JAN 22 8 34 AM '98

LAND CORNER RECORDATION CERTIFICATE
Filing Requirement of Act 74, Mich. P.A. 1970

For corners in

PEGGY A. HAINES
COUNTY CLERK/REGISTER

- COPY -

- COPY -

Liber 00002 Page 0079 RM

Register of Deeds Stamp & File Number

WASHTENAW (County)	Located In: LODI TOWNSHIP	Corner Code #
1. Public Land Survey	T 3S R 5E	G-12
	T R	
	T R	
	T R	
2. Property Controlling in Section	S T R	
	S T R	
3. Miscellaneous Property in Sec.	S T R	
	S T R	

4. Lot No. _____, Recorded Plat _____
5. Private Claims _____

I, PAUL V. SCHWIMMER, in a field survey on DEC 05, 1997 do hereby state that under requirements of P.A. 74, Michigan P.A. of 1970, the corner points mentioned in lines 1 and 2 above were in conformance with regulations and rules therefore as required in the current manual of survey instructions of the United States Department of the Interior, Bureau of Land Management or by a decree of a Court of Law and /or that the corner points mentioned in lines 3, 4 and 5 above were in conformance with the rules of the Michigan Board of Land Surveyors or by a Decree of a Court of Law, established, re-established, monumented, recovered, found as expressed below:

	A	B	C	D	E	F	G	H	I	J	K	L	M
1													
2	6	5	4	3	2	1							
3													
4	7	8	9	10	11	12							
5													
6	18	17	16	15	14	13							
7													
8	19	20	21	22	23	24							
9													
10	30	29	28	27	26	25							
11													
12	31	32	33	34	35	36							
13													

NOTE: Not more than 2 corners, all in the same town and range, may be recorded on this certificate.


A. Description of original monument and accessories and/or subsequent restoration:

G.L.D. (1800'S) SET POST
SUGAR 16 S 73°E 14 LINKS (1) (GONE)
BEECH 7° S 70°W 6 LINKS (2) (GONE)

W.J. ARMSTRONG'S 1934 REMONUMENTATION FIELD NOTES STATE "FOUND NO TRACES OF S. PETTIBONE'S WITNESS TREES, DUG A HOLE IN C/L OF ROAD AND IN RANGE OF FENCES N & S. EXTENDED DIGGING SOUTH AND WEST. FOUND AN OLD WOOD STAKE WITH BROKEN BRICKS AND STONES AROUND IT. RESET WITH 1 1/2" X 36" IRON PIPE, STONES, AND BRICKS. SUBSOIL SANDY GRAVEL. SET 2 RIGHT OF WAY PIPES."
N 54° E 44.5' 16" APPLE (3) (GONE) N 62° E 62.1' 14" MAPLE (5)
N 42° E 83.8' S.W. CORNER HOUSE (4) N 67° E 76.8' 16" MAPLE (6)
CONT'D ON BACK S 27° E 48.7' 14" MAPLE (7) (GONE)

B. Description of corner evidence found and/or method applied in restoring or reestablishing corner:

I RECOVERED A 1" BROKEN AND BENT PINCH TOP IRON PIPE FROM THE ABOVE LISTED WITNESSES. I ALSO RECOVERED PIECES OF BRICK. I REPLACED THIS IRON, WHERE IT WENT STRAIGHT INTO THE GROUND, WITH A 1" BY 18" IRON PIPE AND REMON CAP. THIS NEW IRON WAS SURROUNDED WITH THE REMAINS OF THE BRICK, AND NEW STONES.

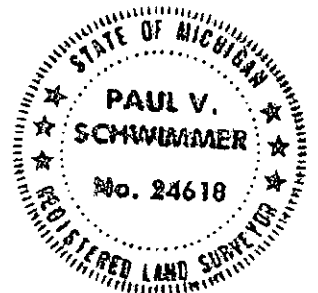

C. Description of monument for corner and accessories established to perpetuate locating the position of the corner:

SET REMONUMENTATION CAP OVER 1" IRON USED TO REPLACE W.J. ARMSTRONG'S IRON. SURROUNDED THIS NEW IRON WITH 2" TO 3" ROCKS.
N 00° E 25.64' NAIL & REMON TAG NEAR FD. NAIL IN W. SIDE UTILITY POLE (8)
N 05° E 30.82' SET NAIL & REMON TAG IN W. SIDE 18" SPRUCE
N 62° E 61.83' SET NAIL & REMON TAG NEAR FD. NAIL IN S.E. SIDE OF 24" MAPLE (5)
N 67° E 76.70' SET NAIL & REMON TAG NEAR FD. NAIL IN S.E. SIDE OF 28" MAPLE (6)
S 10° E 19.00' N.W. CORNER OF BELL TELEPHONE RISER
N 30° W 39.13' SET NAIL & TAG NEAR FD. NAIL IN E. SIDE OF 12" MAPLE
FOUND RIGHT OF WAY IRON NORTHERLY

THE SELECTED LOCATION IS ACCEPTED BY THE CONTRACTOR AND IS GENERALLY ACCEPTED BY PROFESSIONAL SURVEYORS AS THE BEST AVAILABLE EVIDENCE OF THE POSITION OF THE ORIGINAL CORNER.

Signed by Paul V. Schwimmer
Surveyor's Michigan License No. 24618

Date 12-18-1997

APPROVED
DATE 12/9/97

- COPY -

SECTION 'A' CONTINUED

WASHTENAW ENGINEERING RECORDED THIS CORNER IN 1971 (LIBER 1, PAGE 333) WITH THE FOLLOWING WITNESSES:

- N 29° E 75.3' S.W. CORNER HOUSE (4) (REMODELED)
- N 62° E 62.1' 24' MAPLE (5) (MEAS 61.82')
- N 67° E 76.8' 28' MAPLE (6) (MEAS 76.70')
- N 06° E 25.3' UTILITY POLE (8) (MEAS 25.64')

MIDWESTERN CONSULTING, INC. RECORDED THIS CORNER IN 1972 (LIBER 2, PAGE 487) WITH THE FOLLOWING WITNESSES:

- FOUND 1' IRON
- N 42° E 83.8' S.W. CORNER HOUSE (4)
- N 62° E 62.1' 20' MAPLE (5)
- N 67° E 76.8' 28' MAPLE (6)
- R/W PIPES 33.0' NORTH & SOUTH (9)

WASHTENAW ENGINEERING RECORDED THIS POSITION ON AN ACT 132, JOB No. 18697, AND DATED 6-6-1983:

- 3/4" IRON PIPE
- N 29° E 75.3' S.W. CORNER HOUSE (4)
- N 62° E 61.62' NAIL IN 24' MAPLE (5) (MEAS 61.82')
- N 67° E 76.80' NAIL IN 28' MAPLE (6) (MEAS 76.70')
- N 06° E 25.58' NAIL IN UTILITY POLE (8) (MEAS 25.64')

ATWELL-HICKS, INC. ACT 132 SURVEY (LIBER 2388, PAGE 224), DATED 10-4-89, DISCLOSES A SET OF WITNESSES THAT CAN NOT BELONG TO THIS CORNER. THEIR WITNESS-GRID BOOK, DATED AROUND THE SAME TIME HAS REFERENCES TO THE CORRECT ABOVE LISTED WITNESSES.