

MAR 09 1998

RECORDED
WASHTENAW COUNTY, MI

SECTION

LAND CORNER RECORDATION CERTIFICATE JAN 22 8 34 AM '98
Filing Requirement of Act 74, Mich. P.A. 1970

For corners in

WASHTENAW (County)	Located in:	Corner Code #
	LODI TOWNSHIP	
1. Public Land Survey	T <u>3S</u> R <u>5E</u>	<u>G-13</u>
	T _____ R _____	_____
	T _____ R _____	_____
	T _____ R _____	_____
2. Property Controlling in Section	S _____ T _____ R _____	_____
	S _____ T _____ R _____	_____
3. Miscellaneous Property in Sec.	S _____ T _____ R _____	_____
	S _____ T _____ R _____	_____

PEGGY A. HAINES
COUNTY CLERK/REGISTER

- COPY -

- COPY -

Liber 00002 Page 0081
Register of Deeds Stamp & File Number

4. Lot No. _____, Recorded Plat _____
5. Private Claims _____

I, PAUL V. SCHWIMMER, in a field survey on DEC 05, 19 97 do hereby state that under requirements of P.A. 74, Michigan P.A. of 1970, the corner points mentioned in lines 1 and 2 above were in conformance with regulations and rules therefore as required in the current manual of survey instructions of the United States Department of the Interior, Bureau of Land Management or by a decree of a Court of Law and/or that the corner points mentioned in lines 3, 4 and 5 above were in conformance with the rules of the Michigan Board of Land Surveyors or by a Decree of a Court of Law; established, re-established, monumented, recovered, found as expressed below:


NOTE: Not more than 2 corners, all in the same town and range, may be recorded on this certificate.

	A	B	C	D	E	F	G	H	I	J	K	L	M
1													
2	6	5	4	3	2	1							
3													
4	7	8	9	10	11	12							
5													
6	18	17	16	15	14	13							
7													
8	19	20	21	22	23	24							
9													
10	30	29	28	27	26	25							
11													
12	31	32	33	34	35	36							
13													

A. Description of original monument and accessories and/or subsequent restoration:

G.L.D. (1800'S) SET POST
ASH 8 S 14°E 19 LINKS (1) (GONE)
ASH 6 N 01°W 23 LINKS (2) (GONE)

W.J. ARMSTRONG DID NOT ATTEMPT TO RECOVER THIS POSITION IN HIS 1930'S REMONUMENTATION EFFORTS. HOWEVER, IN MR. ARMSTRONG'S LATER WORK HE DID FOR ATWELL-HICKS, IN COMPILING ALL OF ATWELL-HICKS DATA FOR THIS SECTION, HE HAS THE FOLLOWING FOUR WITNESSES:
S 14°E .19 CHAIN 8' ASH (3) (GONE) N 65°E .59 CHAIN 22' BEECH (5) (GONE)
N 01°W .23 CHAIN 6' ASH (4) (GONE) N 90°W .17 CHAIN 10' ASH (6) (GONE)

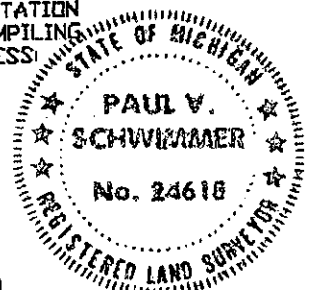

CON'T ON BACK

B. Description of corner evidence found and/or method applied in restoring or reestablishing corner:

I FOUND ATWELL-HICKS 3/4" IRON AT THE BASE OF A WOOD FENCE POST, SURROUNDED BY ROCKS, AT THE INTERSECTION OF FENCE LINES N, S, E, & W. I RAISED THE POSITION BY DRIVING THE ORIGINAL IRON DOWN WITH A 1" X 18" IRON TOPPED WITH AN ALUMINUM REMONUMENTATION CAP. I STACKED ROCKS AROUND THIS POSITION. THE AXEL CASING FOUND 141.48' WESTERLY HAS BEEN RECENTLY FLAGGED WITH NEW NAILS IN SURROUNDING WITNESS TREES. I CONCUR WITH ATWELL-HICKS LOGIC IN PLACING THIS CORNER AT THE FENCE LINE INTERSECTION.

C. Description of monument for corner and accessories established to perpetuate locating the position of the corner:

RAISED FOUND 3/4" IRON PIPE WITH 1" IRON PIPE AND REMONUMENTATION CAP
N 10° W 33.78' SET NAIL & REMON TAG NEAR FD. NAIL IN E. SIDE 20' ASH (7)
N 15° W 15.76' SET NAIL & REMON TAG IN E. SIDE 18' ASH (8)
S 00° E 15.49' SET NAIL & REMON TAG NEAR FD. NAIL IN W. SIDE OF 22' MAPLE (9)
S 80° E 32.64' SET NAIL & REMON TAG NEAR FD. NAIL IN S.E. SIDE OF 18' MAPLE (10)
N 90° W 141.48' FOUND AXEL CASING USED AS FENCE POST

THIS IS NOT A COMMON CORNER TO THE SECTION TO THE SOUTH

THE SELECTED LOCATION IS ACCEPTED BY THE CONTRACTOR AND IS GENERALLY ACCEPTED BY PROFESSIONAL SURVEYORS AS THE BEST AVAILABLE EVIDENCE OF THE POSITION OF THE ORIGINAL CORNER.

Signed by Paul V. Schwimmer
Surveyor's Michigan License No. 24618

Date 12-18-97

APPROVED
DATE 12/9/97
CO. REP. K

- COPY -

SECTION 'A' CONTINUED

ATWELL-HICKS, INC. SET THIS CORNER ON 8-19-94. IN A NOTE TO ME, THEY STATED 'I SET THE CORNER WHERE I DID BECAUSE IT SEEMED TO MAKE SENCE, IT FITS OCCUPATION. ASSUMING THE AXLE IS THE CLOSING CORNER TO THE SOUTH, MY LOCATION IS CLOSE TO THE RECORDED CLOSING DISTANCE (141.48' MEAS MINUS 132' RECORDED = 9.48') IT IS 0.81 FEET NORTH OF THE LINE CONNECTING THE CLOSING CORNER & THE S 1/4. USING MY LOCATION TO COMPUTE THE E 1/2, W 2/3, W 1/2, AND SW 1/4, THESE EXISTING FENCES FIT 2± FEET.

SET 3/4" IRON PIPE AT THE S.W. CORNER OF A CORNER FENCE POST AT INTERSECTION OF N-S AND E-W FENCES.

N 10°W 33.78' 20" HICKORY (7)
N 15°W 15.76' 18" HICKORY (8)
S 00°E 15.49' 22" OAK (9)
S 80°E 32.64' 28" MAPLE (10)