

**SURVEY & REMONUMENTATION**

MAY - 1 1995

**COMMISSION**

**LAND CORNER RECORDATION CERTIFICATE**  
Filing Requirement of Act 74, Mich. P.A. 1970

For corners in

Washtenaw  
(County)

Located In:

Corner Code #

- |                                    |   |           |   |           |             |
|------------------------------------|---|-----------|---|-----------|-------------|
| 1. Public Land Survey              | T | <u>3S</u> | R | <u>5E</u> | <u>I-11</u> |
|                                    | T | _____     | R | _____     | _____       |
|                                    | T | _____     | R | _____     | _____       |
|                                    | T | _____     | R | _____     | _____       |
| 2. Property Controlling in Section | S | _____     | T | _____     | _____       |
|                                    | S | _____     | T | _____     | _____       |
| 3. Miscellaneous Property in Sec.  | S | _____     | T | _____     | _____       |
|                                    | S | _____     | T | _____     | _____       |

4. Lot No. \_\_\_\_\_, Recorded Plat \_\_\_\_\_  
5. Private Claims \_\_\_\_\_

I, Kenneth R. Coleman, in a field survey on October 3, 19 94, do hereby certify that under requirements of P.A. 74, Michigan P.A. of 1970, the corner points mentioned in lines 1 and 2 above were in conformance with regulations and rules therefore as required in the current manual of survey instructions of the United States Department of the Interior, Bureau of Land Management or by a decree of a Court of Law and/or that the corner points mentioned in lines 3, 4 and 5 above were in conformance with the rules of the Michigan Board of Land Surveyors or by a Decree of a Court of Law; established, re-established, monumented, re-monumented, recovered, found as expressed below:

**NOTE: Not more than 4 corners, all in the same town and range, may be recorded on this certificate.**

A. Description of original monument and accessories and/or subsequent restoration:


(see back)

B. Description of corner evidence found and/or method applied in restoring or reestablishing corner:

(see back)

C. Description of monument for corner and accessories established to perpetuate locating the position of the corner:

- Found 3/4" x 24" pinch top. Removed. Set 1" x 24" iron pipe with remonumentation cap.  
5) S60°W 98.22 twin 30" x 34" Poplar in N-S fence line, nail & R.T.  
6) South 1.3 E-W fence line  
7) S80°W 114.28 R.R. tie fence post, nail & R.T.  
N80°E 379.92 14" Elm, nail & R.T.  
S15°W 191.74 28" Poplar, nail & R.T.

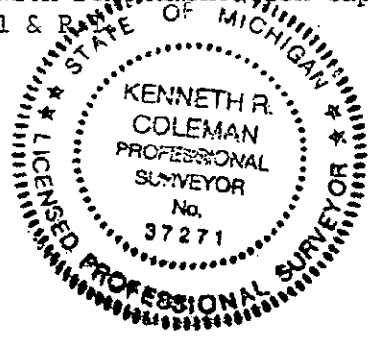

Signed by Kenneth R. Coleman  
Surveyor's Michigan License No. 37271

Date October 10, 1994

LIBER 1 PAGE 158 RM  
- COPY -  
RECORDED  
WASHTENAW COUNTY, MI  
DEC 1 11 31 AM '94  
PEGGY M. HAINES  
COUNTY CLERK/REGISTRAR

Register of Deeds Stamp & File Number

A	B	C	D	E	F	G	H	I	J	K	L	M
2	6	5	4	3	2	1						
3												
4	7	8	9	10	11	12						
5												
6	18	17	16	15	14	13						
7												
8	19	20	21	22	23	24						
9												
10	30	29	28	27	26	25						
11												
12	31	32	33	34	35	36						
13												

RECORDED  
WASHTENAW COUNTY, MI  
DEC 1 11 31 AM '94  
PEGGY M. HAINES  
COUNTY CLERK/REGISTRAR

1

## I-11 Witness Summary

6-21-1918 J. Wampler D.S.  
Set spot at corner of Sections 26, 27, 34 & 35  
1) W. Oak 18 N 83 E 21  
2) B. Oak 14 S 88 W 1.05

P. 260

- copy

(1930's) Pettibone  
Government witnesses:

W.C.R.C. Grid Book, P. 18

- 3) 6" W. Oak, S 5 E, 48.8'
- 4) 10" Y. Oak, N 2 W, 10.6'

7-21-73 Midwestern Consulting, Inc.  
Found 3/4" Iron Pipe

Survey-Job #73392

- 5) 24" Poplar Spk. in N. side S35°W 97.05
- 6) 1.2" North of E-W fence

9-30-75 Midwestern Consulting, Inc.  
Found 3/4" Iron Pipe

Liber 4, Page 400, W.C.R.

- 5) 24" Poplar, S 35 W, 97.0'
- 6) 1.2' North of E-W fence
- 7) 117.0' East of a wandering fence line.  
(Corner perpetuated by found 3/4" Iron Pipe)

9-12-85 Midwestern Consulting, Inc.  
Found 3/4" Iron Pipe

Survey-Job #85181

- 5) 24" Poplar, spike in N side, S 35 W, 97.05'
- 6) 1.2' North of E-W fence

12-14-93 Atwell-Hicks, Inc.  
Found 3/4" Iron Pipe

- 5) 24" poplar, spike in N. side S35°W, 97.05'
- 6) 1.2' N. of E-W fence
- 7) 117.0' E. of Wandering fence line

APPROVED

DATE 3/8/94CO. REP. VA

7