

MAY - 1 1995

COMMISSION

COPY

LAND CORNER RECORDATION CERTIFICATE  
Filing Requirement of Act 74, Mich. P.A. 1970

RECORDED  
WASHTENAW COUNTY, MI

JAN 10 9 42 AM '95

PEGGY M. HAINES  
COUNTY CLERK/REGISTER

-COPY-

LIBER 1 PAGE 251 Rm  
-COPY-  
Register of Deeds Stamp & File Number

For corners in

Washtenaw (County)	Located In:	Corner Code #
1. Public Land Survey	T <u>3S</u> R <u>5E</u>	<u>I-12</u>
	T _____ R _____	_____
	T _____ R _____	_____
	T _____ R _____	_____
2. Property Controlling in Section	S _____ T _____ R _____	_____
	S _____ T _____ R _____	_____
3. Miscellaneous Property in Sec.	S _____ T _____ R _____	_____
	S _____ T _____ R _____	_____

- 4. Lot No. \_\_\_\_\_, Recorded Plat \_\_\_\_\_
- 5. Private Claims \_\_\_\_\_

A	B	C	D	E	F	G	H	I	J	K	L	M
2	6	5	4	3	2	1						
3												
4	7	8	9	10	11	12						
5												
6	18	17	16	15	14	13						
7												
8	19	20	21	22	23	24						
9												
10	30	29	28	27	26	25						
11												
12	31	32	33	34	35	36						
13												

I, Kenneth R. Coleman in a field survey on 5-23, 19 94, do hereby certify that under requirements of P.A. 74, Michigan P.A. of 1970, the corner points mentioned in lines 1 and 2 above were in conformance with regulations and rules therefore as required in the current manual of survey instructions of the United States Department of the Interior, Bureau of Land Management or by a decree of a Court of Law and/or that the corner points mentioned in lines 3, 4 and 5 above were in conformance with the rules of the Michigan Board of Land Surveyors or by a Decree of a Court of Law; established, re-established, monumented, re-monumented, recovered, found as expressed below:

NOTE: Not more than 4 corners, all in the same town and range, may be recorded on this certificate.


A. Description of original monument and accessories and/or subsequent restoration:  
See back of sheet.

B. Description of corner evidence found and/or method applied in restoring or reestablishing corner:

Found 1/2" iron pipe 12-14-93  
See back of sheet.

C. Description of monument for corner and accessories established to perpetuate locating the position of the corner:

Found 3/4" iron pipe. Removed. Found 1 1/2" iron pipe 1' below grade w/brick fragments.  
Raised w/ 1" iron pipw w/ remonumentation cap.  
13) S 30° E 205.04 NW corner House #3375, wood siding corner  
17) S 10° W 58.99 8" Pine, RT E. face  
18) S 40° E 78.92 5" Maple, RT NE face  
20) N 80° W 126.89 RR tie corner fence post, RT

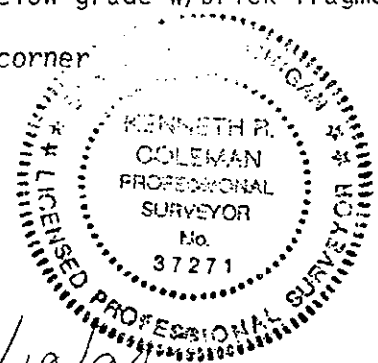

Signed by Kenneth R. Coleman Date 9/19/94  
Surveyor's Michigan License No. 37271

I-12 Witness Summary

LIBER

1 PAGE 252 RM  
- COPY -  
Page 260

6-21-1819 J. Wampler D.S.

Set 1/2 mile post

- 1) B.O. 9 S4W 33
- 2) D.O. 7 N81W51

4-5-38

W.J. Armstrong

W.C.R.C. Field Book Page 53

Set 1 1/2" Iron Pipe and bricks

- 3) BM on R.O., 16", N 70 E, 44.55'
- 4) 18" R. Oak, N 18 W, 46.8'
- 5) 8" Apple, S 26 E, 24.93'
- 6) 28" B. Oak, N 80 W, 193.7'
- 7) 1 1/2" Iron Pipe, N 1 1/2 W, 33.0'
- 8) Telephone pole, N 50 W, 33.2'

07-20-73 A.R. Rentschler

Liber 3, Page 399

found 1-1/2" Iron

- 9) Spike in top of fence post North 30.42
- 10) Corner falls in Centerline travelled road (Saline-Waterworks)

12-11-81 Norman N. Fahrner

Liber 6, Page 226

Found 1 1/2" Iron Pipe.

- 9) Fence post, Northerly, 30.85' to nail
- 11) MBT Box, Southerly, 32.51' top center
- 12) Mail Box, S 40 E, 60.5'
- 13) NW Corner of house, S 30 E, 205.32'

3-30-87 Atwell-Hicks, Inc.

Survey-Job #37096

1/2" Iron Pipe in C/L of gravel road.

- 14) Telephone riser 4"x2', N'ly, 31.0'
- 11) Telephone riser 4"x2', S'ly, 32.3'
- 15) N. edge gravel road, 11.5'
- 16) C/L drive to house #3398, 43.0'

1-22-90

Midwestern Consulting

Survey-Job #89300

Found 2" Iron Pipe.

- 17) 4" Pine, S 10 W, 59.1'
- 18) 4" Maple, S 40 E, 79.0'
- 19) 5" Oak, N 45 E, 89.0'

1-7-91

Washtenaw Engineering

Survey-Job #23252

Found 1 1/2" Iron Pipe.

- 13) NW corner of house #3375, S 30 E, 205.32'
- 9) Fence post, N'ly, 30.85' to nail
- 11) MBT Box, S'ly, 32.51' (Top center)
- 12) Mail Box, S 40 E, 60.5'

5-23-94

Atwell-Hicks, Inc.

Found 3/4" Iron Pipe w/ obliterated cap over 1 1/2" iron pipe w/brick fragments 1' below grade, raised with 1" iron pipe

- 11) MBT box S'Ly, 32.51 (top center)
- 12) Mail Box S40E, 60.5'
- 13) NW Corner of House #3375 S30E, 205.04'
- 17) Set R.T. E.Face of 8" pine S10°W 58.99'
- 18) Set R.T. NE. Face of 5" mpale S40°E 78.92'
- 20) Set R.T. S.Face of R.R.Tie fence cor. post N80°W 126.89'

APPROVED

DATE 5/31/94

CO. REP. KA