

**SURVEY & REMONUMENTATION**

MAY - 1 1995

**COMMISSION**

**LAND CORNER RECORDATION CERTIFICATE**  
Filing Requirement of Act 74, Mich. P.A. 1970

For corners in

<u>Washtenaw</u> <small>(County)</small>	Located In:	Corner Code <u>J-13</u>
1. Public Land Survey	T <u>3S</u> R <u>5E</u>	<u>J-13</u>
	T _____ R _____	_____
	T _____ R _____	_____
	T _____ R _____	_____
2. Property Controlling in Section	S _____ T _____ R _____	_____
	S _____ T _____ R _____	_____
3. Miscellaneous Property in Sec.	S _____ T _____ R _____	_____
	S _____ T _____ R _____	_____
4. Lot No. _____, Recorded Plat _____		
5. Private Claims _____		

LIBER 1 PAGE 156 Rm  
copy  
Dec 1 11 30 AM '94  
RECORDED  
WASHTENAW COUNTY, MI  
PEGGY M. HAINES  
COUNTY CLERK/REGISTER  
- COPY -

Register of Deeds Stamp & File Number

A	B	C	D	E	F	G	H	I	J	K	L	M
2	6	5	4	3	2	1						
3												
4	7	8	9	10	11	12						
5												
6	18	17	16	15	14	13						
7												
8	19	20	21	22	23	24						
9												
10	30	29	28	27	26	25						
11												
12	31	32	33	34	35	36						
13												

I, Kenneth R. Coleman, in a field survey on October 24, 19 94, do hereby certify that under requirements of P.A. 74, Michigan P.A. of 1970, the corner points mentioned in lines 1 and 2 above were in conformance with regulations and rules therefore as required in the current manual of survey instructions of the United States Department of the Interior, Bureau of Land Management or by a decree of a Court of Law and/or that the corner points mentioned in lines 3, 4 and 5 above were in conformance with the rules of the Michigan Board of Land Surveyors or by a Decree of a Court of Law; established, re-established, monumented, re-monumented, recovered, found as expressed below:

**NOTE: Not more than 4 corners, all in the same town and range, may be recorded on this certificate.**

A. Description of original monument and accessories and/or subsequent restoration:


See back of sheet.

B. Description of corner evidence found and/or method applied in restoring or reestablishing corner:

Found 3/4" iron bar 12-16-94  
See back of sheet.

C. Description of monument for corner and accessories established to perpetuate locating the position of the corner:

Found 3/4" x 36" iron bar. Replaced with 1" x 24" iron pipe with remonumentation cap.  
5) North 2.44 12" fence post, RT, nail  
N45°W 8.46 22" basswood, RT, nail  
N50°E 16.45 8" hickory, RT, nail  
S80°E 17.63 8" basswood, RT, nail

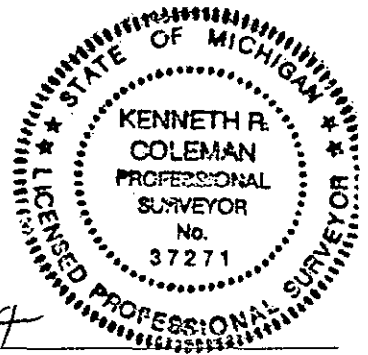

Signed by Kenneth R. Coleman Date 10/24/94  
Surveyor's Michigan License No. 37271

## J-13 Witness Summary

11-28-1815 J. Wampler D.S.

Page 406

Set the q sec post from which

- 1) a W. Oak 24 in di bears S 51 E 16 Lks dist
- 2) a Do. 30 in di bears N 65 E 27 links dist

1969 Washtenaw Engineering

Found I.P.

- 3) @ N-S, E-W Fence Int.
- 4) 22" Maple N 45 W 3.4'
- 5) S. Face 12" Fence Post N 1.9'

12-14-93 Atwell-Hicks, Inc.

Found 3/4" Iron Bar

- 3) @ N-S, E-W fence int.
- 4) Dead 22" Maple N45W 3.4'
- 5) S. Face 12" Fence Post N.1.9'

PROVED  
DATE 6/13/94  
REP. KA