

**SURVEY &
REMONUMENTATION**

MAY - 1 1995

COMMISSION

COPY

LAND CORNER RECORDATION CERTIFICATE
Filing Requirement of Act 74, Mich. P.A. 1970

RECORDED
WASHTENAW COUNTY, MI

JAN 10 9 42 AM '95

PEGGY H. HAINES
COUNTY CLERK/REGISTER

-COPY-

For corners in

Washtenaw (County)	Located In:	Corner Code #
1. Public Land Survey	T <u>3S</u> R <u>5E</u>	<u>K-9</u>
	T _____ R _____	_____
	T _____ R _____	_____
	T _____ R _____	_____
2. Property Controlling in Section	S _____ T _____ R _____	_____
	S _____ T _____ R _____	_____
3. Miscellaneous Property in Sec.	S _____ T _____ R _____	_____
	S _____ T _____ R _____	_____

LIBER

1 PAGE 257 RM

-COPY-

Register of Deeds Stamp & File Number

4. Lot No. _____, Recorded Plat _____
5. Private Claims _____

	A	B	C	D	E	F	G	H	I	J	K	L	M
2	6		5		4		3		2		1		
3													
4	7		8		9		10		11		12		
5													
6	10		17		16		15		14		13		
7													
8	19		20		21		22		23		24		
9													
10	30		29		28		27		26		25		
11													
12	31		32		33		34		35		36		
13													

I, Kenneth R. Coleman in a field survey on July 12, 19 94, do hereby certify that under requirements of P.A. 74, Michigan P.A. of 1970, the corner points mentioned in lines 1 and 2 above were in conformance with regulations and rules therefore as required in the current manual of survey instructions of the United States Department of the Interior, Bureau of Land Management or by a decree of a Court of Law and/or that the corner points mentioned in lines 3, 4 and 5 above were in conformance with the rules of the Michigan Board of Land Surveyors or by a Decree of a Court of Law; established, re-established, monumented, re-monumented, recovered, found as expressed below:


NOTE: Not more than 4 corners, all in the same town and range, may be recorded on this certificate.

A. Description of original monument and accessories and/or subsequent restoration:
See back of sheet

B. Description of corner evidence found and/or method applied in restoring or reestablishing corner:
Found 3/4" iron pipe 12-14-93
See back of sheet

C. Description of monument for corner and accessories established to perpetuate locating the position of the corner:
Found 3/4" x 8" iron pipe set over 1 1/4" iron pipe.
Removed 3/4" iron pipe. Set mon. box over 1 1/4" pipe.

- 3) N60°E 83.67 SW Corner Base of Howe Monument in cemetery
- 4) S50°E 143.65 NW Corner House
- 9) S10°W 34.84 P. Pole, RT, nail
- 11) N55°W 49.70 P. Pole, RT, nail

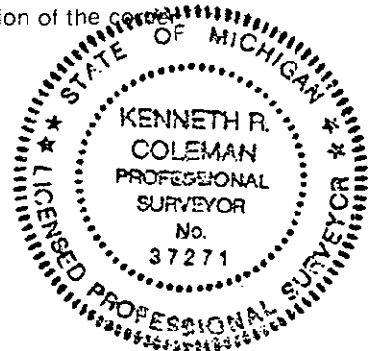

Signed by Kenneth R. Coleman Date 9/19/94
Surveyor's Michigan License No. 37271

K-9 Witness Summary

LIBER

1 PAGE 258 RM
-copy-

6-21-1819 J. Wampler D.S.
Set Post corner S. 23, 24, 25 & 26
1) B.O. 20 S 73W39
2) D.O. 14 S 26E48

(1930's) W.C.R.C. Grid Book, P. 14
Iron pipe and stones.
Corner of the base of Howe monument in Cemetery
3) SW N 56 1/2 E, 84.5'
4) NW Corner of house, S 51 E, 143.7'
5) 18" Maple, S 39 1/2 E, 86.35'
6) 12" Sycamore, N 21/2 W, 258.0'
7) 14.6' West of centerline of road

10-16-78 Charles Wilson Liber 5, Page 100 Found Iron Pipe
4) NW Corner of House S 51 E, 143.7'
5) 28" Maple S 39 1/2 E, 86.35'
6) 28" Sycamore N 2 1/2 W, 258.0'

5-5-82 Norman Fahrner Liber 6, Page 228, W.C.R.
Set 1 1/2" Iron Pipe in Westerly edge of asphalt
3) SW Cor. of base of Howe Monument in Cemetery, N 56 E, 84.5'
4) NW Cor. of house, S 51 E, 143.7'
8) Telephone pole, S 40 E, 65.63' to nail
9) Power pole, S 25 W, 34.46'
10) Telephone pole, N 50 W, 49.65'
11) Telephone pole, N 35 E, 82.63' to nail

1-19-85 Robert A. Campbell Jr. Liber 7, Page 38, W.C.R.
Reset with 3/4" x 9" Iron Pipe and cap at road surface over the 1
1/2" Iron Pipe.
4) N.W. Cor. of house S51°E 143.7'
6) 28" Sycamore N2-1/2°W 258.0'
9) Utility pole, S 26 W, 34.48' set nail SE side
10) Telephone pole, N 50 W, 49.63' set nail NE side
11) Telephone pole, N 32 E, 82.70' set nail W. side
12) Existing C/L Saline-Ann Arbor Rd., East, 17.4'
13) Existing C/L Textile Rd., South, 3.0'

12-14-93 Atwell-Hicks, Inc.
Found 3/4" iron pipe with cap
3) SW Cor. base of Howe monument in cemetery, N56-1/2°E, 84.5'
4) NW Cor. of house S51°E 143.7'
9) Nail SE side Util. Pole S26°W, 34.48'
10) Nail NE side Tele. Pole N50°W, 49.63'
11) Nail W. side - Tele N50°W, 49.63'
12) Centerline Saline-Ann Arbor Rd. East 17.4'
13) Centerline Textile Rd. South 3.0'

APPROVED

DATE 2/13/94

CO. REP. KA