

MAY - 1 1995

COMMISSION

COPY

LAND CORNER RECORDATION CERTIFICATE
Filing Requirement of Act 74, Mich. P.A. 1970

RECORDED
 WASHTENAW COUNTY, MI

JAN 10 9 42 AM '95

PEGGY M. HAINES
 COUNTY CLERK/REGISTER

- COPY -

For corners in

<u>Washtenaw</u> <small>(County)</small>	Located In:	Corner Code #
1. Public Land Survey	T <u>3S</u> R <u>5E</u>	<u>K-10</u>
	T _____ R _____	_____
	T _____ R _____	_____
	T _____ R _____	_____
2. Property Controlling in Section	S _____ T _____ R _____	_____
	S _____ T _____ R _____	_____
3. Miscellaneous Property in Sec.	S _____ T _____ R _____	_____
	S _____ T _____ R _____	_____

LIBER 1 PAGE 259 RM

- Copy -

Register of Deeds Stamp & File Number

4. Lot No. _____, Recorded Plat _____
 5. Private Claims _____

	A	B	C	D	E	F	G	H	I	J	K	L	M
2	6		5		4		3		2		1		
3													
4	7		8		9		10		11		12		
5													
6	18		17		16		15		14		13		
7													
8	19		20		21		22		23		24		
9													
10	30		29		28		27		26		25		
11													
12	31		32		33		34		35		36		
13													


I, Kenneth R. Coleman in a field survey on 6-29, 19 94, do hereby certify that under requirements of P.A. 74, Michigan P.A. of 1970, the corner points mentioned in lines 1 and 2 above were in conformance with regulations and rules therefore as required in the current manual of survey instructions of the United States Department of the Interior, Bureau of Land Management or by a decree of a Court of Law and/or that the corner points mentioned in lines 3, 4 and 5 above were in conformance with the rules of the Michigan Board of Land Surveyors or by a Decree of a Court of Law; established, re-established, monumented, re-monumented, recovered, found as expressed below:

NOTE: Not more than 4 corners, all in the same town and range, may be recorded on this certificate.

A. Description of original monument and accessories and/or subsequent restoration:
 See back of sheet.

B. Description of corner evidence found and/or method applied in restoring or reestablishing corner:
 Found 3/4" iron pipe 12-14-93
 See back of sheet.

C. Description of monument for corner and accessories established to perpetuate locating the position of the corner:
 Found 3/4" pipe with W.C.R.C. #13028 cap in mon. box. Set remonumentation as follows:
 7) N 50° E 42.54 P. pole, RT
 8) South 33.48 P. pole, RT
 14) S 40° W 55.45 Blue Spruce, RT
 16) N 15° W 49.92 14" Maple, RT

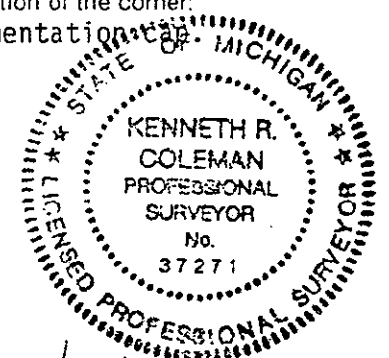

Signed by Kenneth R. Coleman Date 9/19/94
 Surveyor's Michigan License No. 37271

K-10 Witness Summary

LIBER

1 PAGE 260 Rm

-copy-

6-21-1819 J. Wampler, D.S. Page 258

Set 1/2 Mile post

- 1) W.O. 4 N 77E 54
- 2) D.O. 6 S 75E 66

(1930's) Pettibone

W.C.R.C. Grid Book, P. 17

Government witnesses:

- 3) 13" W. Oak, S 10 E, 221.1'
- 4) 10" W. Oak, S 38 E, 46.2'

10-8-55 Atwell-Hicks, Inc.

Book 592 Pg. 17

Found

- 5) 48" W.O. S5°E 286.8'
- 6) 12" Poplar S56°E 83.7'

1-17-80 Thomas L. Sutherland

Liber 6, Page 19, W.C.R.

Found Iron Pipe

- 6) 18" Poplar, S 50 E, 83.7'
- 7) Utility pole, N 50 E, 42.60' to nail
- 8) Utility pole, S 05 E, 33.45' to nail
- 9) NE Cor. House, S 25 W, 126.8'
- 10) R/W Pipe, South, 33.0'

12-22-80 Robert A. Campbell Jr.

Liber 6, Page 71, W.C.R.

Found 3/4" Iron Pipe. Raised to road surface with 3/4"x18" Iron Pipe & plastic cap in monument box.

- 6) 26" Poplar S58°E 83.79' Fnd nail NE side
- 7) Power pole N66°E 42.56' Fnd nail SE side
- 8) Tele. Pole S3°E 33.48' Fnd nail W. side
- 10) 1" iron pipe S5°W 32.86'
- 11) 3/4" Square Iron Bar, N 03 E, 32.93'
- 12) 14" Twain Box Elder S9°W 34.8'
- 13) 7" Maple N15°W 50.1'
- 14) 8" Spruce S54°W 55.2'

1-25-80 Washtenaw Engineering

Survey-Job #17288

Found Iron Pipe.

- 6) 18" Poplar, S 50 E, 83.7'
- 7) Utility pole, N 50 E, 42.60' to nail
- 8) Utility pole, S 05 E, 33.46' to nail
- 9) NE Cor. House, S 25 W, 126.8'
- 10) R/W Pipe, South, 33.0'

2-25-88 Atwell-Hicks, Inc.

Found Iron pipe

- 6) 36" Poplar S50°E 83.80
- 12) Twin 15" Elm S5°E 34.60
- 13) 10" Maple N10°W 50.20
- 15) 10" Maple N30°E 57.80

12-14-93 Atwell-Hicks, Inc.

Found 3/4" Iron pipe with WCRC cap in Mon. Box

- 6) 36" Poplar S60°E 83.80'
- 7) P. Pole N60E 42.4' Found nail SE side
- 8) Tele. Pole South, 33.47' Found nail W. side
- 9) NE cor. house S25°W 126.8'
- 12) Twin 15" Elm S5°E 34.60'
- 13) 10" Maple N30°E 57.80'
- 14) 8" Spruce S54°W 55.2'
- 15) 10" Maple N30°E 57.80'

APPROVED

DATE 6/13/94

CO. REP. EA