

SURVEY & REMONUMENTATION

MAY - 1 1995

COMMISSION

For corners in

Washtenaw (County)

Located In:

Corner Code #/

1. Public Land Survey	T	3S	R	5E	K-13
	T		R		
	T		R		
	T		R		
2. Property Controlling in Section	S		T	R	
	S		T	R	
3. Miscellaneous Property in Sec.	S		T	R	
	S		T	R	

LAND CORNER RECORDATION CERTIFICATE
Filing Requirement of Act 74, Mich. P.A. 1970

COPY

RECORDED
WASHTENAW COUNTY, MI

JAN 10 9 43 AM '95

PEGGY H. HAINES
COUNTY CLERK/REGISTER

- COPY -

LIBER 1 PAGE 265 RM
- COPY -
Register of Deeds Stamp & File Number

- 4. Lot No. _____, Recorded Plat _____
- 5. Private Claims _____

A	B	C	D	E	F	G	H	I	J	K	L	M
2	6	5	4	3	2	1						
3												
4	7	8	9	10	11	12						
5												
6	18	17	16	15	14	13						
7												
8	19	20	21	22	23	24						
9												
10	30	29	28	27	26	25						
11												
12	31	32	33	34	35	36						
13												


I, Kenneth R. Coleman in a field survey on 9-18, 19 94 do hereby certify that under requirements of P.A. 74, Michigan P.A. of 1970, the corner points mentioned in lines 1 and 2 above were in conformance with regulations and rules therefore as required in the current manual of survey instructions of the United States Department of the Interior, Bureau of Land Management or by a decree of a Court of Law and/or that the corner points mentioned in lines 3, 4 and 5 above were in conformance with the rules of the Michigan Board of Land Surveyors or by a Decree of a Court of Law; established, re-established, monumented, re-monumented, recovered, found as expressed below:

NOTE: Not more than 4 corners, all in the same town and range, may be recorded on this certificate.

A. Description of original monument and accessories and/or subsequent restoration:
See back of sheet.

B. Description of corner evidence found and/or method applied in restoring or reestablishing corner:
Found 1 1/4" iron bar 12-14-93
See back of sheet.

C. Description of monument for corner and accessories established to perpetuate locating the position of the corner:
Found 1 1/4" x 4' iron bar. Replaced w/ 1" x 36" iron pipe with remonumentation cap.
West 4.33 12" Cherry, RT, nail
North 20.30 10" Cherry, RT, nail
N 75° E 15.12 12" Cherry, RT, nail
S 15° W 13.25 14" x 8" Twin Boxelder, RT, nail

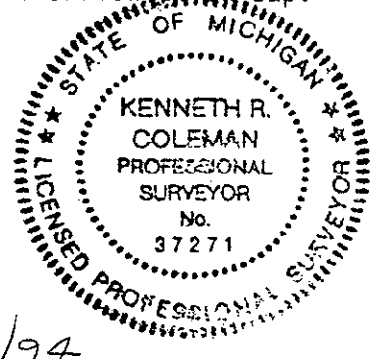

Signed by Kenneth R. Coleman Date 9/19/94
Surveyor's Michigan License No. 37271

K-13 Witness Summary

LIBER

1 PAGE 266 RM

- Copy -
Page 406

11-28-1815 J. Wampler D.S.

Set a post for the Cor. of Secs 35 & 36 from which

- 1) a W. Oak 18 in di bears N 7 E 27 Lks dist
- 2) an Elm 5 in di bears S 14E 8 Lks dist

1935 E. Erstling

W.C.R.C. Grid Book, P. 21

Car Axle (10" below surface).

- 3) 12" Willow, East 77.87'
- 4) 6" Elm, S.E. 52.0'
- 5) 16" Elm, South, 2.36' (nail on W side of tree)
- 6) 16" Elm, South, 2.38' (nail on E side of tree)
- 7) app. 170' W of E bank
- 8) app. 190' S of N bank on West Saline.

1-8-44 Atwell-Hicks, Inc.

Field Book 518, P. 63

Found Car Axle

- 3) 12" Willow E'ly 77.87'
- 4) 6" Elm SE 52.0'
- 5) Nail W. Side 16" Elm 2.36'
- 6) Nail E. Side 16" Elm 2.38'

10-20-58 Atwell-Hicks, Inc.

Compiled Survey Records

- 3) 12" Willow, East, 77.8'
- 4) 6" Elm, S.E., 52.0'
- 5) 16" Elm, South, 2.26', Nail in W. side of tree
- 6) 16" Elm, South, 2.38', Nail in E. side of tree

12-14-94 Atwell-Hicks, Inc.

Found 1 1/4" iron bar 1' below Grade

- 6) 16" Elm, South, 2.38',

APPROVED

DATE 3/8/94

CO. REP. H