

**SURVEY &
REMONUMENTATION**

MAY - 1 1995

COMMISSION

COPY

**LAND CORNER RECORDATION CERTIFICATE
Filing Requirement of Act 74, Mich. P.A. 1970**

RECORDED
WASHTENAW COUNTY, MI

JAN 10 9 43 AM '95

PEGGY M. HAINES
COUNTY CLERK/REGISTER

-COPY-

For corners in

<u>Washtenaw</u> <small>(County)</small>	Located In:	Corner Code #
1. Public Land Survey	T <u>3S</u> R <u>5E</u>	<u>L-11</u>
	T _____ R _____	_____
	T _____ R _____	_____
	T _____ R _____	_____
2. Property Controlling in Section	S _____ T _____ R _____	_____
	S _____ T _____ R _____	_____
3. Miscellaneous Property in Sec.	S _____ T _____ R _____	_____
	S _____ T _____ R _____	_____

LIBER 1 PAGE 269 *RM*
-COPY-
Register of Deeds Stamp & File Number

4. Lot No. _____, Recorded Plat _____
5. Private Claims _____

	A	B	C	D	E	F	G	H	I	J	K	L	M
2	6		5		4		3		2		1		
3													
4	7		8		9		10		11		12		
5													
6	18		17		16		15		14		13		
7													
8	19		20		21		22		23		24		
9													
10	30		29		28		27		26		25		
11													
12	31		32		33		34		35		36		
13													


I, Kenneth R. Coleman, in a field survey on 5-23, 19 94, do hereby certify that under requirements of P.A. 74, Michigan P.A. of 1970, the corner points mentioned in lines 1 and 2 above were in conformance with regulations and rules therefore as required in the current manual of survey instructions of the United States Department of the Interior, Bureau of Land Management or by a decree of a Court of Law and/or that the corner points mentioned in lines 3, 4 and 5 above were in conformance with the rules of the Michigan Board of Land Surveyors or by a Decree of a Court of Law; established, re-established, monumented, re-monumented, recovered, found as expressed below:

NOTE: Not more than 4 corners, all in the same town and range, may be recorded on this certificate.

A. Description of original monument and accessories and/or subsequent restoration:
See back of sheet.

B. Description of corner evidence found and/or method applied in restoring or reestablishing corner:
Found "T" iron 12-14-93
See back of sheet.

C. Description of monument for corner and accessories established to perpetuate locating the position of the corner:
Found "T" iron. Removed. Found nothing else. Reset w/ 1" iron pipe w/ removable cap.
8) N 80° W 8.34 10" Hickory, RT, nail, NE face
9) West 24.78 38" Oak. RT S. face
14) S 20° E 33.18 12" Basswood
15) North 27.02 14" Hickory, RT, nail, E. face
16) NW 1.0 Fence corner, Fence W & N

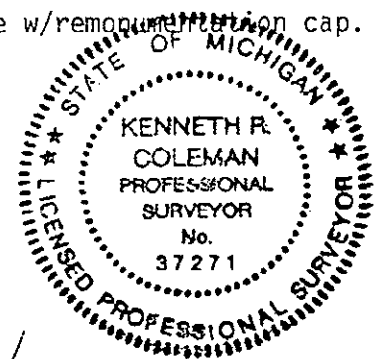

Signed by Kenneth R. Coleman Date 9/19/94
Surveyor's Michigan License No. 37271

I-11 Witness Summary

LIBER 1 PAGE 270 Km
- Copy -
Page 258

6-14-1819 J. Wampler D.S.
Set 1/4 S post at av. D.
1) R.G. 30 S10W 18
2) W.O. 7 N8W 8

10-20-55 Compiled drawings AHI
Found stake & stones by S.B. Pettibone
3) Fence cor. post
4) W. Oak 28" W 1/2° N, .45
5) Int. E-W 1/4 line & centerline Ann Arbor-Saline Rd. W, 657.1

07-18-68 Atwell-Hicks, Inc.
Found old spike top of 12" fence post - replaced with boat spike.
5) Int. E-W 1/4 line & A2-Saline Rd. W, 657.10
6) 14" Hickory N88°W 19.1
7) 12" Walnut East 47.6

08-30-79 Washtenaw Engineering Co. Inc.
5) Int. E-W 1/4 line & centerline A2-Saline Rd. W, 656.96

1-17-80 Thomas L. Sutherland Liber 6, Page 18, W.C.R.
Found 'T' Iron.
7) 16" Walnut, Easterly, 47.27' to nail
8) 8" Hickory, N 50 W, 8.47' to nail
9) 28" Oak, N 70 W, 24.85' to nail
10) 4" Mult. T. Apple, N 40 E, 43.00' to nail

06-23-89 Timothy Tietsema
Found "T" Iron
5) Int. E-W 1/4 line & centerline A2-Saline Rd. W, 656.80
11) 36" Oak N30°E 23.75 (9?)
12) 8" Triple Walnut North 8.30
13) 15" Oak S60°E 46.45 (??)

12-14-93 Atwell-Hicks, Inc.
Found 'T' iron at
3) 12" Fence corner post leaning north 0.8 to S side
6) 18" Shag. Hick. N75°W 19.5 to center tree
7) 18" Walnut Easterly 46.3' to nail
8) 10" S. Hickory N70°W 8.2 to nail NE side
9) 36" Oak N80°W, 23.3 to nail E side
10) 3 x 4" Mult. t. Apple N40°E 43.2' to nail SW side
12) Triple 8" Oak N30°W 8.0 to nail S. side

APPROVED
DATE 3/18/94
CO. REP. KA