

**SURVEY & REMONUMENTATION**

MAY - 1 1995

**COMMISSION**

**COPY**

**LAND CORNER RECORDATION CERTIFICATE**  
Filing Requirement of Act 74, Mich. P.A. 1970

RECORDED  
WASHTENAW COUNTY, MI

JAN 10 9 43 AM '95

PEGGY M. HAINES  
COUNTY CLERK/REGISTER

- COPY -

For corners in

Washtenaw <small>(County)</small>	Located In:	Corner Code #
1. Public Land Survey	T <u>3S</u> R <u>5E</u>	<u>M-9</u>
	T _____ R _____	_____
	T _____ R _____	_____
	T _____ R _____	_____
2. Property Controlling in Section	S _____ T _____ R _____	_____
	S _____ T _____ R _____	_____
3. Miscellaneous Property in Sec.	S _____ T _____ R _____	_____
	S _____ T _____ R _____	_____

LIBER 1 PAGE 271 RM  
Register of Deeds Stamp & File Number

4. Lot No. \_\_\_\_\_, Recorded Plat \_\_\_\_\_  
5. Private Claims \_\_\_\_\_

I, Kenneth R. Coleman in a field survey on July 12, 19 94, do hereby certify that under requirements of P.A. 74, Michigan P.A. of 1970, the corner points mentioned in lines 1 and 2 above were in conformance with regulations and rules therefore as required in the current manual of survey instructions of the United States Department of the Interior, Bureau of Land Management or by a decree of a Court of Law and/or that the corner points mentioned in lines 3, 4 and 5 above were in conformance with the rules of the Michigan Board of Land Surveyors or by a Decree of a Court of Law; established, re-established, monumented, re-monumented, recovered, found as expressed below:

**NOTE: Not more than 4 corners, all in the same town and range, may be recorded on this certificate.**


	A	B	C	D	E	F	G	H	I	J	K	L	M
2	6	5	4	3	2	1							
3													
4	7	8	9	10	11	12							
5													
6	18	17	16	15	14	13							
7													
8	19	20	21	22	23	24							
9													
10	30	29	28	27	26	25							
11													
12	31	32	33	34	35	36							
13													

A. Description of original monument and accessories and/or subsequent restoration:  
See back of sheet

B. Description of corner evidence found and/or method applied in restoring or reestablishing corner:  
Found 3/4" iron pipe 12-14-93  
See back of sheet

C. Description of monument for corner and accessories established to perpetuate locating the position of the corner:  
Found 3/4" iron pipe w/W.C.R.C. cap. Set mon. box over it.

5) S20°W	36.58	48" Oak, RT, nail
7) S35°W	70.90	32" Maple, RT, nail
	S30°W	48.41 C/L Conc. Hitching Post
	S10°W	125.78 70" Oak, RT, nail

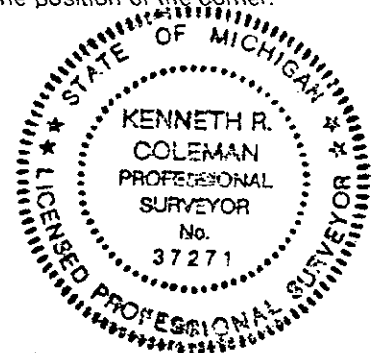

Signed by Kenneth R. Coleman Date 9/19/94  
Surveyor's Michigan License No. 37271

M-9 Witness Summary

LIBER 1 PAGE 272 km  
Page 408y -

11-27-1815 J. Wampler D.S.  
Set Post for the cor. of Secs 24 & 25  
1) From which a White Oak 12" in Dia. bears  
2) S 2°E 350 Links Dist. No other timber near.

8-6-34 W.J. Armstrong W.C.R.C. Grid Book, Page 14  
Found the mark of an old wood stake and a mass of stones, Reset  
with 1 1/2"x40" iron pipe, stones and bricks.  
3) 12" B. Cherry, S 71 E, 56.7'  
4) 28" B. Oak, S 15 E, 28.3'  
5) 40" B. Oak, S 21/2 W, 36.6'  
6) 36" B. Oak, S 20 W, 39.2'  
7) 16" Maple, S 35 W, 71.0'  
8) 6" Choke Cherry, N 41 E, 20.7'  
9) Corner of Sections 19/30 Pittsfield Twp., North 147.6'

10-20-72 Atwell-Hicks, Inc. Liber 2, Page 387, W.C.R.  
Found 1 1/2" Iron Pipe.  
3) 12" Black Cherry, S 71 E, 56.7'  
5) 40" Black Oak, S 21 W, 36.6'  
7) 24" Maple, S 35 W, 71.0'  
10) 56" Oak, S 10 W, 124.1'  
11) 12" Oak, N 55 E, 42.1'  
12) 12" Walnut, N 60 E, 66.9'  
9) Cor. 19/30 Pittsfield Twp., North, 147.6'

4-11-78 Norman N. Fahrner Liber 5, Page 42, W.C.R.  
Found 1 1/2" Iron Pipe  
3) 12" Black Cherry, S 71 E, 56.7'  
7) 28" Maple, S 35 W, 71.05'  
13) Silver Maple Clump, N 05 W, 89.27' to nail  
14) NE Cor. Conc. Post S 30 W, 47.6'

12-15-83 Atwell-Hicks, Inc. Job # 35205  
Found 1/2" I.P.  
3) 12" Black Cherry S71°E 56.7'  
5) 40" Black Oak S21°W 36.6'  
7) 24" Maple S35°W 71.0'  
10) 56" Oak S10°W 124.1'  
11) 12" Oak N55°E 42.1'  
9) Cor. 19 & 30 of Pittsfield Township North 147.6  
12) 12" Walnut N60°E 66.9'

7-31-91 Atwell-Hicks, Inc. Job # 90430  
Found 3/4"  
9) Corner of Sec. 19 & 30 of Pittsfield Township North 147.6'  
7) W. Face 24" Maple S35°W 71.0' to Nail  
5) E. Face 40" B. Oak S21°W 36.6' to Nail  
13) W. Face 56" W. Oak S10°W 125.7' to Gear Pin

12-14-93 Atwell-Hicks, Inc.  
Found 3/4" Iron pipe w/obliterated cap  
5) E. face 40 B. Oak S21°W 36.6' to Nail  
7) W. face 24" Maple S35°W 71.0' to Nail  
13) W. face 56" W.Oak S10°W 125.7' to gear pin

12-14-93 Atwell-Hicks, Inc.  
Found 3/4" iron pipe with obliterated cap  
5) E. face 40" B. Oak S21°W 36.6' to Nail  
7) W. face 24" Maple S35°W 71.0' to Nail  
13) W. face 56" W.Oak S10°W 125.7' to gear pin

APPROVED  
DATE 3/8/94  
CO. REP. KA