

SURVEY &
REMONUMENTATION

COPY

RECORDED
WASHTENAW COUNTY, MI

MAY - 1 1995

LAND CORNER RECORDATION CERTIFICATE
Filing Requirement of Act 74, Mich. P.A. 1970

JAN 10 9 44 AM '95

For corners in **COMMISSION**

PEGGY H. HAINES
COUNTY CLERK/REGISTER

Washtenaw Located In: Corner Code #
(County)

- COPY -

- | | | |
|------------------------------------|-------------------------|-------------|
| 1. Public Land Survey | T <u>3S</u> R <u>5E</u> | <u>M-10</u> |
| | T _____ R _____ | _____ |
| | T _____ R _____ | _____ |
| | T _____ R _____ | _____ |
| 2. Property Controlling in Section | S _____ T _____ R _____ | _____ |
| | S _____ T _____ R _____ | _____ |
| 3. Miscellaneous Property in Sec. | S _____ T _____ R _____ | _____ |
| | S _____ T _____ R _____ | _____ |

LIDER 1 PAGE 273 Rm
- COPY -
Register of Deeds Stamp & File Number

4. Lot No. _____, Recorded Plat _____
5. Private Claims _____

	A	B	C	D	E	F	G	H	I	J	K	L	M
2	6		5		4		3		2		1		
3													
4	7		8		9		10		11		12		
5													
6	18		17		16		15		14		13		
7													
8	19		20		21		22		23		24		
9													
10	30		29		28		27		26		25		
11													
12	31		32		33		34		35		36		
13													

I, Kenneth R. Coleman in a field survey on July 12, 1994, do hereby certify that under requirements of P.A. 74, Michigan P.A. of 1970, the corner points mentioned in lines 1 and 2 above were in conformance with regulations and rules therefore as required in the current manual of survey instructions of the United States Department of the Interior, Bureau of Land Management or by a decree of a Court of Law and/or that the corner points mentioned in lines 3, 4 and 5 above were in conformance with the rules of the Michigan Board of Land Surveyors or by a Decree of a Court of Law; established, re-established, monumented, re-monumented, recovered, found as expressed below:


NOTE: Not more than 4 corners, all in the same town and range, may be recorded on this certificate.

A. Description of original monument and accessories and/or subsequent restoration:
See back of sheet

B. Description of corner evidence found and/or method applied in restoring or reestablishing corner:
Found stone 12-14-93
See back of sheet

C. Description of monument for corner and accessories established to perpetuate locating the position of the corner:
Found and removed stone. Set 1 1/2" x 24" iron pipe w/remonumentation tag.

West	22.10	8" Elm, RT, nail
N80°W	18.65	12" Oak, RT, nail
North	27.82	14" Elm, RT, nail
North	20.63	8" Elm, RT, nail

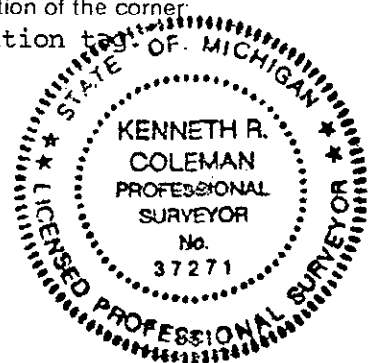

Signed by Kenneth R. Coleman Date 9/19/94
Surveyor's Michigan License No. 37271

M-10 Witness Summary

LIBER

1 PAGE 274 km

- copy -

11-27-1815 GLO J. Wampler D.S. P. 408

Set the qr. Section post from which

- 1) a W. Oak 16 in dia bears N87W 122 links dist.
- 2) a B. Oak 18 in dia bears N83E 98 links dist.

8-1-34 J. Armstrong W.C.R.C. Grid Book, P. 17,
Found this post to be a slab of granite with Mico in it. It is 4"
thick x 10" wide and stands
16" above ground about 3' E of fence corner. Did not disturb as it
is very solid.

- 3) 28" Forked W.O., West 144.5'
- 4) 12" B. Oak, West, 118.4'
- 5) 12" Sassafras, N 80 W, 10.6'
- 6) 14" B. Oak, South, 147.5'

8-5-72 Allen R. Rentschler Liber 2, Page 309, W.C.R.
Found 4"x10" slab of granite

- 5) 18" Black Oak, West, 118.4'
- 6) 18" Sassafras, N 80 W, 10.6'
- 7) 24" Black Oak, South, 147.5'

09/19/72 R.J. Jagow Liber 2, Page 387

Found Granite Slab 4"x10"x16" High

- | | | |
|--------------------------|-------|--------|
| 3) 42" Forked White Oak | West | 145.0' |
| 4) 20" & 14" Twin BL Oak | West | 118.0' |
| 5) 24" Sassafras | N80°W | 10.6' |
| 6) 30" Black Oak | South | 148.0' |

12-20-72 Robert J. Jagow Liber 2, Page 475, W.C.R.
Reference tie to W 1/4 corner Section 30, T3S, R6E, Pittsfield
Township.

- 7) 3/4" Iron Pipe, North, 131.5' (W 1/4 Corner, Sec. 30)

04/07/78 Norman Fahrner Liber 5, Page 42, W.C.R.
Found 4"x10"x16" Stone above ground

- | | | |
|----------------------|-------|---------------|
| 3) 36" Forked W. Oak | West | 144.5' |
| 4) 20" B. Oak | West | 118.4' |
| 5) 18" Sassafras | N80°W | 10.6' |
| 6) 24" B. Oak | South | 147.5' |
| 7) 6" Oak | North | 16.35 to nail |

12-14-93 Atwell-Hicks, Inc.

Found granite slab 4" x 10" x 16" High

- | | | |
|----------------------|--------|-------------------------|
| 3) 42" Forked W. Oak | West | 144.5' |
| 4) 20" B. Oak | West | 118.4' |
| 5) 18" Sassafras | N 80 W | 10.6, Standing but dead |
| 7) 6" Oak | North | 16.35' |

APPROVED

DATE 2/8/94

CO. REP. KA