

SURVEY & REMONUMENTATION

MAY - 1 1995

COMMISSION

LAND CORNER RECORDATION CERTIFICATE
Filing Requirement of Act 74, Mich. P.A. 1970

For corners in

Washtenaw (County)	Located In:	Corner Code #
1. Public Land Survey	T <u>3S</u> R <u>5E</u>	M-13
	T _____ R _____	_____
	T _____ R _____	_____
	T _____ R _____	_____
2. Property Controlling in Section	S _____ T _____ R _____	_____
	S _____ T _____ R _____	_____
3. Miscellaneous Property in Sec.	S _____ T _____ R _____	_____
	S _____ T _____ R _____	_____

RECORDED
 WASHTEENAW COUNTY, MI
 Dec 1 11 30 AM '94
 PEGGY M. HAINES
 COUNTY CLERK/REGISTRAR
 -copy-

LIBER 1 PAGE 150 RM
Register of Deeds Stamp & File Number

- 4. Lot No. _____, Recorded Plat _____
- 5. Private Claims _____

I, Kenneth R. Coleman, in a field survey on October 3, 19 94, do hereby certify that under requirements of P.A. 74, Michigan P.A. of 1970, the corner points mentioned in lines 1 and 2 above were in conformance with regulations and rules therefore as required in the current manual of survey instructions of the United States Department of the Interior, Bureau of Land Management or by a decree of a Court of Law and/or that the corner points mentioned in lines 3, 4 and 5 above were in conformance with the rules of the Michigan Board of Land Surveyors or by a Decree of a Court of Law; established, re-established, monumented, re-monumented, recovered, found as expressed below:

NOTE: Not more than 4 corners, all in the same town and range, may be recorded on this certificate.

	A	B	C	D	E	F	G	H	J	K	L	M
2	6	5	4	3	2	1						
3												
4	7	8	9	10	11	12						
5												
6	16	17	16	15	14	13						
7												
8	19	20	21	22	23	24						
9												
10	30	29	28	27	26	25						
11												
12	31	32	33	34	35	36						
13												

A. Description of original monument and accessories and/or subsequent restoration:


(see back)

B. Description of corner evidence found and/or method applied in restoring or reestablishing corner:

(see back)

C. Description of monument for corner and accessories established to perpetuate locating the position of the corner:

- Found 1" iron pipe, set remonumentation cap on pipe.
- 3) North 33.30 48" Oak, nail & R.T.
 - 7) South 5.65 1/2" iron pipe
 - 9) South 3.25 1" iron pipe
 - East 5.11 12" Boxelder, nail & R.T.
 - West 33.29 8" Hickory, nail & R.T.
 - N65°W 30.83 8" Hickory, nail & R.T.

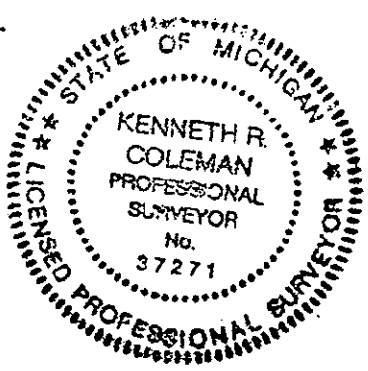

Signed by Kenneth R. Coleman Date October 10, 1994

Surveyor's Michigan License No. 37271

1

Witness Summary

11-27-1815 J. Wampler D.S.
Corner of T3S & T4S, R5E & R6E from which
a W. Oak 10 in d. bears S30E 36 Lks dist.
a D. 14 in d. bears N26W 43 Lks dist.

P. 407

(1930's) H.H. Atwell W.C.R.C. Grid Book, P. 20,
Iron Pipe.

- 24" Burr Oak, North 38.3'
- 17" Hickory, S'ly, 13.6'
- 8" Elm, S'ly, 2.0'
- 16" Elm, NE, 30.8'

12-14-93 Atwell-Hicks, Inc.

Found 1" Iron Pipe

- 48" Burr Oak, North 33.25 to center
- Fd. 1/2" iron pipe, South 5.65'
- Fd. 3/4" pinch top, North 231.17'
- Fd. 1" iron pipe, South 3.25'
- Fd. 3/4" iron pipe W/A-H Cap, North 199.12'

APPROVED
DATE 5/31/94
CO. REP. KA