

**SURVEY & REMONUMENTATION**

LAND CORNER RECORDATION CERTIFICATE  
Filing Requirement of Act 74, Mich. P.A. 1970

NOV 02 1999

SECTION

For corners in WASHTENAW (County)

Located In: T 3S R 6E Corner Code # A-11

1. Public Land Survey  
PITTSFIELD TWP T \_\_\_\_\_ R \_\_\_\_\_ CC \_\_\_\_\_


2. Property controlling in Section S \_\_\_\_\_ T \_\_\_\_\_ R \_\_\_\_\_

3. Miscellaneous Property in Sec. S \_\_\_\_\_ T \_\_\_\_\_ R \_\_\_\_\_

4. Lot No. \_\_\_\_\_, Recorded Plat \_\_\_\_\_

5. Private Claims \_\_\_\_\_

5017283  
Page: 1 of 2  
02/25/1999 02:59P  
CORREM L-2 P-133  
Peggy M. Haines - Washtenaw Co. CORREM  
**COPY**

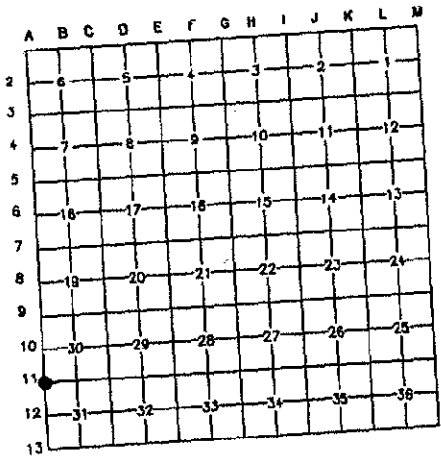

I, LORLE E. BEYER, in a field survey on MARCH 24, 19 98, do hereby certify that under requirements of P.A. 74, Michigan P.A. of 1970, the corner points mentioned in lines 1 and 2 above were in conformance with regulations and rules therefore as required in the current manual of survey instructions of the United States Department of the Interior, Bureau of Land Management or by decree of a Court of Law and/or that the corner points mentioned in lines 3, 4 and 5 above were in conformance with the rules of the Michigan Board of Land Surveyors or by Decree of a Court of Law; established, re-established, monumented, re-monumented, recovered, found as expressed below:

SW CORNER SECTION 30

A. Description of original monument and accessories and/or subsequent restoration:

G.L.O. - 1819  
28" B.O. N 38° W 99 LKS (65.3')  
30" W.O. S 41° E 100 LKS (66.0')

C.S. WOODARD - 1887  
NOT FOUND BUT REESTABLISHED BY CAREFUL LINE AND MEASUREMENT  
NO WITNESSES LISTED

Continued on Back

B. Description of corner evidence and/or method applied in restoring or reestablishing corner:

FOUND 4" CONCRETE MONUMENT WITH 1/2" IRON ROD.  
FOUND FOUR (4) REMAINING WITNESSES.  
SET ALUMINUM REMON. CAP - STAMPED WITH '41092'.

C. Description of monument for corner and accessories established to perpetuate locating the position of the corner:

4" CONCRETE MONUMENT WITH 1/2" IRON ROD WITH ALUMINUM REMON. CAP STAMPED WITH '41092'.  
AT GROUND SURFACE.

(4) 14" CHERRY	NORTH	60.2'	FOUND STUMP
(9) SE COR SEC 25 LODI TWP	S 06° W	101.79'	SET NAIL/TAG EAST SIDE
(10) 24" OSAGE ORANGE	S 12° W	3.59'	FOUND NAIL NORTH SIDE
(11) 10" OSAGE ORANGE	S 81° W	1.65'	
(12) 1 1/2" METAL POST	S 81° E	142.68'	
(13) SW CORNER HSE #1371	N 33° E	181.31'	
(14) 11" BLACK CHERRY	N 07° E	96.59'	SET NAIL/TAG EAST SIDE

THIS CORNER IS NOT COMMON WITH M-11 OF LODI TWP.  
AFTER CAREFUL EXAMINATION OF RECORD DOCUMENTATION AND FIELD OBSERVATIONS, I BELIEVE THIS POINT SHOULD BE ACCEPTED AS THE BEST AVAILABLE EVIDENCE OF THE POSITION OF THE ORIGINAL CORNER.  
THIS CORNER WAS RATIFIED BY THE PEER REVIEW COMMITTEE IN NOVEMBER, 1998.

Signed by Lorle E. Beyer  
Surveyor's Michigan License No. 41092

Date Dec 23, 1999

FORM APPROVED BY MICHIGAN STATE BOARD OF LAND SURVEYORS, JAN. 28, 1971  
REVISED MAY 14, 1975  
REVISED JAN., 1983

APPROVED  
DATE 11-9-98  
CO. REP. KA

**COPY**

A-11



5017283  
Page: 2 of 2  
02/25/1999 02:59P  
L-2 P-134

Peggy M. Haines - Washtenaw Co. CORREM

COPY

Continued from Section A:

W.J. Armstrong - August 1934 - Washtenaw County Road Commission Grid Book

Found an old wood stake and pieces of tile. Reset with a 1" x 36" Iron Pipe and put stones and bricks around it.

- |                           |         |        |  |
|---------------------------|---------|--------|--|
| 1) 6" Wild Plum           | S 35° W | 110.7' |  |
| 2) 24" Hickory            | S 45° W | 153.1' |  |
| 3) Clump 30" Osage Orange | S 85° W | 9.5'   |  |
| 4) 14" Cherry             | North   | 60.2'  |  |
- Bearings Estimated

Allen R. Rentschler, RLS 15411 - August 1972 - LCRC Liber 2 Page 311

Found 1" Iron Pipe

- |                     |       |       |
|---------------------|-------|-------|
| 4) 18" Cherry       | North | 60.2' |
| 5) 12" Osage Orange | West  | 3.2'  |

Robert Jagow, RLS 6998 - September 1972 - LCRC Liber 2 Page 473

Found 1" Iron Pipe

- |                           |       |        |
|---------------------------|-------|--------|
| 4) 14" Cherry             | North | 60.2'  |
| 6) 6"-10" Tw Osage Orange | SW    | 2.6'   |
| 7) Fence Line East        | North | 5.6'   |
| 8) Fence Line North       | East  | 1.4'   |
| 9) SE Cor Sec 25 Lodi     | South | 101.6' |

Plat - "Brookview Highlands" - Liber 26 of Plats, Pages 59-61  
Richard Timmons, RLS 23319, June 1989

Kevin M. Anderson, PLS - 1991 - Washtenaw County Road Commission Field Book H-12

Found 4" Concrete Monument with 1/2" rebar in center

- |                         |         |                |
|-------------------------|---------|----------------|
| 4) 20" Stump            | North   | 60.1'          |
| 6) 9"-14" Osage Orange  | S 02° W | 2.6'           |
| 7) Fence Line East      | North   | 5.6'           |
| 8) Fence Line North     | West    | 1.4'           |
| 9) SE Cor Sec 25 Lodi   | South   | 101.75'        |
| 1) 10) 24" Osage Orange | S 08° W | 3.59' Fnd Nail |
| 11) 9" Osage Orange     | S 87° W | 1.65' Fnd Nail |

SURVEY &  
REMONUMENTATION

NOV 02 1999

SECTION

5017283