

SURVEY & REMONUMENTATION

NOV 02 1999

LAND CORNER RECORDATION CERTIFICATE
Filing Requirement of Act 74, Mich. P.A. 1970

SECTION

For corners in

WASHTENAW
(County)

Located In:

Corner Code #

1. Public Land Survey
PITTSFIELD TWP

T 3S R 6E

C-11

2. Property controlling
in Section

S _____ T _____ R _____

3. Miscellaneous
Property in Sec.

S _____ T _____ R _____




5017289
Page: 1 of 2
02/25/1999 02:59P

COPY
Register of Deeds Stamp & File Number

4. Lot No. _____, Recorded Plat _____

5. Private Claims _____

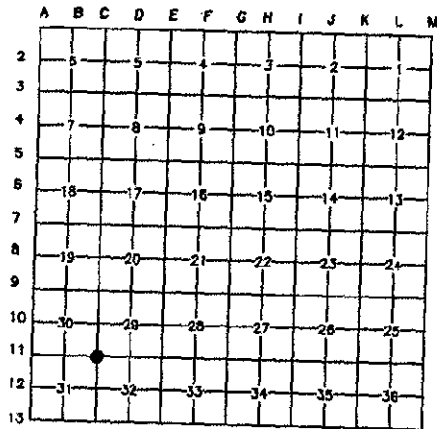

I, LORI E. BEYER, in a field survey on MARCH 24, 19 98, do hereby certify that under requirements of P.A. 74, Michigan P.A. of 1970, the corner points mentioned in lines 1 and 2 above were in conformance with regulations and rules therefore as required in the current manual of survey instructions of the United States Department of the Interior, Bureau of Land Management or by decree of a Court of Law and/or that the corner points mentioned in lines 3, 4 and 5 above were in conformance with the rules of the Michigan Board of Land Surveyors or by Decree of a Court of Law; established, re-established, monumented, re-monumented, recovered, found as expressed below:

SE CORNER SECTION 30

A. Description of original monument and accessories and/or subsequent restoration:

- G.L.O. - 1819
- 17" W.O. N 77° W 38 LKS
- 18" D.O. N 80° E 48 LKS
- C.S. WOODARD - 1887
- B.O. 10" N 65° W 32 LKS
- HICKORY 5" S 54° W 23 LKS
- SET STAKE AND STONES

Continued on Back

B. Description of corner evidence and/or method applied in restoring or reestablishing corner:

FOUND 1/2" IRON BAR IN 4" BROKEN CONCRETE MONUMENT, BENT S'LY. CUT TOP TO STRAIGHTEN.

FOUND TWO (2) REMAINING WITNESSES.

PLACED ALUMINUM REMON CAP STAMPED '41092'.

C. Description of monument for corner and accessories established to perpetuate locating the position of the corner:

1/2" IRON BAR IN 4" CONCRETE MONUMENT WITH ALUMINUM REMON CAP STAMPED '41092'.

- | | | | |
|-----------------------------|---------|---------|---------------------|
| (1) 36" OAK STUMP | S 28° W | 12.05' | FOUND NAIL W SIDE |
| (9) FENCE LINE INTERSECTION | NORTH | +/- 90' | OLD ROLLED-UP FENCE |
| (13) 25" OAK | S 06° W | 70.56' | SET NAIL/TAG E SIDE |
| (14) 13" HICKORY | N 04° E | 50.53' | SET NAIL/TAG W FACE |
| (15) TOP NUT HYDRANT | N 20° W | 30.94' | |
| (16) POWER POLE | N 73° W | 85.59' | SET NAIL/TAG S SIDE |
| (17) BACK OF CURB | WEST | 23.2' | |



AFTER CAREFUL EXAMINATION OF RECORD DOCUMENTATION AND FIELD OBSERVATIONS, I BELIEVE THIS POINT SHOULD BE ACCEPTED AS BEST AVAILABLE EVIDENCE OF THE POSITION OF THE ORIGINAL CORNER. THIS CORNER WAS RATIFIED BY THE PEER REVIEW COMMITTEE IN NOVEMBER, 1998.

Signed by Lori E. Beyer
Surveyor's Michigan License No. 41092

Date DEC 23, 1998

APPROVED
DATE 11-5-98
CO. REP. [Signature]

COPY



5017289
 Page: 2 of 2
 02/25/1999 02:59P
 L-2 P-146

Continued from Section A:

COPY

No Washtenaw County Road Commission Grid Book witnesses posted.

Robert J. Jagow - RLS 6998 - October 1973 - L.C.R.C. Liber 3 Page 315

Did not list source of witnesses, but described the following witnesses in Section A:

- 1 1/4" Iron Pipe
- | | | |
|-------------------------|---------|-------|
| 1) 22" Red Oak | S 30° W | 12.3' |
| 2) 10" Hickory | S 80° W | 15.7' |
| 3) 14" Hickory | S 70° W | 18.5' |
| 4) 18" Elm | N 03° W | 34.0' |
| 5) 5" Hickory | N 16° W | 18.8' |
| 6) 14" W. Oak | S 69° W | 21.7' |
| 7) 14" Red Oak | N 70° W | 5.5' |
| 8) N-S Fence Line | West | 1.0' |
| 9) F. Line Intersection | North | 85.5' |

Section B listed as follows:

- Found 3/4" Iron Pipe
- | | | |
|-------------------------|---------|-------|
| 1) 30" W. Oak | S 20° W | 12.5' |
| 10) 24" W. Oak | S 23° W | 22.5' |
| 6) 16" Red Oak | S 60° W | 21.8' |
| 2) 22" Shagbark Hickory | S 80° W | 15.8' |
| 11) 16" B. Oak | North | 6.0' |
| 12) 20" W. Oak | N 80° W | 18.0' |
| 9) F. Line Intersection | North | 87.0' |
| 8) N-S Fence Line | West | 0.4' |

P.V. Schwimmer - RLS 24618 - 1990 - 'Donald E. Shelton Industrial Park South' - Recorded Plat

**SURVEY &
 REMONUMENTATION**

NOV 02 1999

SECTION