

SURVEY & REMONUMENTATION

NOV 02 1999


LAND CORNER RECORDATION CERTIFICATE  
Filing Requirement of Act 74, Mich. P.A. 1970

SECTION

For corners in

WASHTENAW (County)	Located In:	Corner Code #
1. Public Land Survey PITTSFIELD TWP	T <u>3S</u> R <u>6E</u>	<u>C-12</u>
	T _____ R _____	_____
	T _____ R _____	_____
2. Property controlling in Section	S _____ T _____ R _____	_____
	S _____ T _____ R _____	_____
3. Miscellaneous Property in Sec.	S _____ T _____ R _____	_____
	S _____ T _____ R _____	_____
4. Lot No. _____, Recorded Plot _____		
5. Private Claims _____		

5017290  
Page: 1 of 2  
02/25/1999 02:59P  
Peggy M. Haines - Washtenaw Co. CORREM L-2 P-147  
Register of Deeds Stamp & File Number

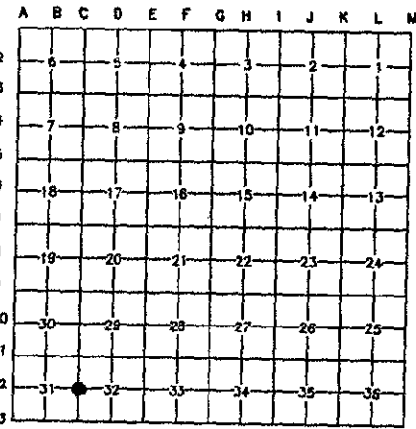

I, LORI E. BEYER, in a field survey on MARCH 24, 19 98, do hereby certify that under requirements of P.A. 74, Michigan P.A. of 1970, the corner points mentioned in lines 1 and 2 above were in conformance with regulations and rules therefore as required in the current manual of survey instructions of the United States Department of the Interior, Bureau of Land Management or by decree of a Court of Law and/or that the corner points mentioned in lines 3,4 and 5 above were in conformance with the rules of the Michigan Board of Land Surveyors or by Decree of a Court of Law; established, re-established, monumented, re-monumented, recovered, found as expressed below:

W 1/4 CORNER SECTION 31

A. Description of original monument and accessories and/or subsequent restoration:

G.L.O. - 1819  
16" W.O. S 68° W 116 LKS (76.6')  
17" D.O. N 70° W 125 LKS (82.5')  
NO C.S. WOODARD NOTES (1887) FOUND.

Continued on Back

B. Description of corner evidence and/or method applied in restoring or reestablishing corner:

FOUND 1/2" IRON BAR IN 4" BROKEN CONCRETE MONUMENT.  
CUT TO STRAIGHTEN  
FOUND NO WITNESSES.  
PLACED ALUMINUM REMON CAP STAMPED '41092'.

C. Description of monument for corner and accessories established to perpetuate locating the position of the corner:

1/2" IRON BAR IN 4" CONCRETE MONUMENT, WITH ALUMINUM REMON CAP STAMPED '41092', AT GROUND SURFACE.

(5) POWER POLE	N 54° W	98.69'	SET NAIL/TAG NE SIDE
(6) 11" HICKORY	N 01° W	9.24'	FOUND NAIL/TAG W FACE
(7) TOP NUT HYDRANT	S 24° W	38.69'	
(8) 12" ASH	S 02° W	41.76'	SET NAIL/TAG W FACE
(9) POWER POLE	S 54° E	103.47'	SET NAIL/TAG NE SIDE
(10) BACK OF CURB	WEST	23.6'	



AFTER CAREFUL EXAMINATION OF RECORD DOCUMENTATION AND FIELD OBSERVATIONS, I BELIEVE THIS POINT SHOULD BE ACCEPTED AS BEST AVAILABLE EVIDENCE OF THE POSITION OF THE ORIGINAL CORNER.

THIS CORNER WAS RATIFIED BY THE PEER REVIEW COMMITTEE IN NOVEMBER, 1998.

Signed by Lori E. Beyer Date DEC 23, 1998  
Surveyor's Michigan License No. 41092

APPROVED  
DATE 11-9-98  
CO. REP. W

COPY



5017290

Page: 2 of 2

02/25/1999 02:59P

Continued from Section A:

Peggy M. Haines - Washtenaw Co. CORREM L-2 P-148

COPY

W.J. Armstrong - RLS 2444 - November 1956 - Washtenaw County Road Commission Grid Book

Found old wood stake. Reset with 1 1/2" x 40" Iron Pipe with stones and bricks.

1) 14" Butternut	N 01° E	99.1'
2) 3" Elm	S 40° E	95.7'
3) 13" Butternut	S 01° E	66.3'
4) 15" Butternut	S 30° W	97.1'

P.V. Schwimmer - RLS 24618 - 1990 - 'Donald E. Shelton Industrial Park South' - Recorded Plat

SURVEY &  
REMONUMENTATION

NOV 02 1999

SECTION