

SURVEY & REMONUMENTATION

NOV 02 1999


LAND CORNER RECORDATION CERTIFICATE
Filing Requirement of Act 74, Mich. P.A. 1970

SECTION

For corners in

<u>WASHTENAW</u> (County)	Located in:	Corner Code #
1. Public Land Survey PITTSFIELD TWP	T <u>3S</u> R <u>6E</u>	<u>C-13</u>
2. Property controlling in Section	T _____ R _____	_____
3. Miscellaneous Property in Sec.	S _____ T _____ R _____	_____
4. Lot No. _____, Recorded Plat _____	S _____ T _____ R _____	_____
5. Private Claims _____	S _____ T _____ R _____	_____

5017291
Page: 1 of 2
02/25/1999 02:59P
L-2 P-149
Peggy M. Haines - Washtenaw Co. CORREM
Register of Deeds Stamp & File Number

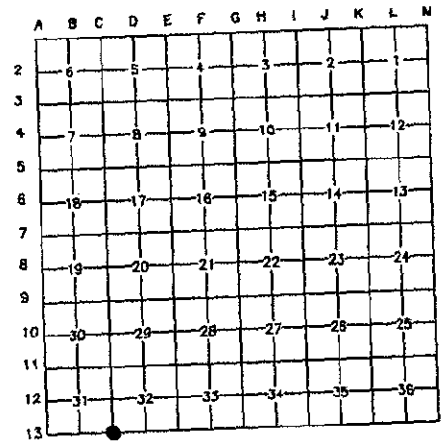

I, LORI E. BEYER, in a field survey on MARCH 24, 19 98, do hereby certify that under requirements of P.A. 74, Michigan P.A. of 1970, the corner points mentioned in lines 1 and 2 above were in conformance with regulations and rules therefore as required in the current manual of survey instructions of the United States Department of the Interior, Bureau of Land Management or by decree of a Court of Law and/or that the corner points mentioned in lines 3, 4 and 5 above were in conformance with the rules of the Michigan Board of Land Surveyors or by Decree of a Court of Law; established, re-established, monumented, re-monumented, recovered, found as expressed below:

SE CORNER SECTION 31

A. Description of original monument and accessories and/or subsequent restoration:

G.L.O. - 1815
W.O. 24" S 6° E 32 LKS
W.O. 20" N 20° E 1.15 CH

C.S. WOODARD - 1887
PLAT SHOWS CORNER IDENTIFIED AND REESTABLISHED.
NO WITNESSES LISTED

Continued on Back


B. Description of corner evidence and/or method applied in restoring or reestablishing corner:

FOUND 3/4" IRON PIPE AT PAVEMENT SURFACE IN CL OF BEMIS ROAD.
FOUND FOUR (4) REMAINING WITNESSES
PLACED MONUMENT BOX OVER EXISTING 3/4" IRON PIPE.
PLACED ALUMINUM REMON CAP OVER 3/4" IRON PIPE - STAMPED WITH '41092'.

C. Description of monument for corner and accessories established to perpetuate locating the position of the corner:

3/4" IRON PIPE WITH ALUMINUM REMON. CAP STAMPED WITH '41092' INSIDE MONUMENT BOX.

(3) 14" HICKORY	N 10' W	31.27'	SET NAIL/TAG	E FACE
(4) 14" HICKORY	N 65' W	71.64'	SET NAIL/TAG	E FACE
(5) 12" HICKORY	N 71' W	103.87'		
(6) 1/2" R.O.W. IRON	NORTH	32.97'		
(9) 12" CMP CULVERT	S 47' W	53.3'	E END	
(10) CABLE RISER	S 25' W	32.3'	TOP CENTER	
(11) 1/2" IRON PIPE	N 60° E	54.31'		
(12) 1/2" IRON PIPE	N 48° W	53.8'		
NE COR SEC 6, T4S, R6E	WEST	170.6'		

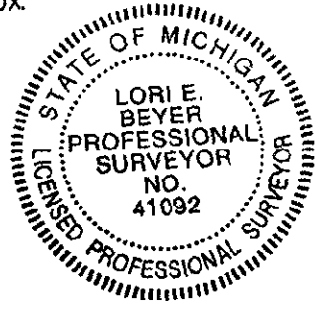

AFTER CAREFUL EXAMINATION OF RECORD DOCUMENTATION AND FIELD OBSERVATIONS, I BELIEVE THIS POINT SHOULD BE ACCEPTED AS A CAREFUL AND FAITHFUL PERPETUATION OF THE POSITION OF THE ORIGINAL CORNER.
THIS CORNER WAS RATIFIED BY THE PEER REVIEW COMMITTEE IN NOVEMBER, 1998.

Signed by Lori E. Beyer
Surveyor's Michigan License No. 41092

Date Dec 27, 1998

FORM APPROVED BY MICHIGAN STATE BOARD OF LAND SURVEYORS, JAN. 28, 1971
REVISED MAY 14, 1975
REVISED JAN., 1983

APPROVED
DATE 11-9-98
BY [Signature]

COPY

C-13

5017291
Page: 2 of 2
02/25/1999 02:59P
L-2 P-150

Peggy M. Haines - Washtenaw Co. CORREM

COPY

Continued from Section A:

W.J. Armstrong - December 1932 - Washtenaw County Road Commission Grid Book
 Found a wood stake inside a 5" tile with stones around it. Reset with a 1 1/2" x 42"
 Iron Pipe leaving tile in place and placed 4 bricks around it.

- 1) 1" Hickory N 62° E 55.0'
- 2) 1" Hickory N 53 1/2° E 42.5'
- 3) 1" Hickory N 08° W 31.4'
- 4) 1" Hickory N 68° W 71.9'
- 5) 1" Hickory N 72° W 104.5'
- 6) ROW Pipe
- 7) ROW Pipe

Unknown - November 1966 - Washtenaw County Road Commission Grid Book - Handwritten Notes

- 3) 7" Hickory N 08° W 31.4'
- 4) 8" Hickory N 68° W 71.9'
- 8) Edison Pole S 53° W 47.03'

Norman N. Fahrner, RLS 17620 - September 1971 - LCRC Liber 1 Page 291

- Found 3/4" Iron Pipe
- 5) 8" Hickory N 72° W 104.5'
 - 4) 8" Hickory N 68° W 71.9'
 - 3) 8" Hickory N 08° W 31.4'

Norman N. Fahrner, RLS 17620 - September 1977 - LCRC Liber 4 Page 328

- Found 3/4" Iron Pipe
- 3) 9" Hickory N 08° W 31.4'
 - 4) 10" Hickory N 68° W 71.5'
 - 5) 9" Hickory N 72° W 104.5'
 - 6) ROW Pipe
 - 7) ROW Pipe
 - 8) Utility Pole S 53° W 46.95' Nail

**SURVEY &
REMONUMENTATION**

NOV 02 1999

SECTION