

SURVEY & REMONUMENTATION

NOV 02 1999

LAND CORNER RECORDATION CERTIFICATE
Filing Requirement of Act 74, Mich. P.A. 1970


SECTION

For corners in

<u>WASHTENAW</u> (County)	Located In:	Corner Code #
1. Public Land Survey	T <u>3S</u> R <u>6E</u>	<u>E-9</u>
PITTSFIELD TWP	T _____ R _____	_____
	T _____ R _____	_____
	T _____ R _____	_____
2. Property controlling in Section	S _____ T _____ R _____	_____
	S _____ T _____ R _____	_____
3. Miscellaneous Property in Sec.	S _____ T _____ R _____	_____
	S _____ T _____ R _____	_____
4. Lot No. _____, Recorded Plat _____		
5. Private Claims _____		

5017294
Page: 1 of 2
02/25/1999 02:59P
Peggy M. Haines - Washtenaw Co. CORREM L-2 P-155
Register of Deeds Stamp & File Number

I, LORI E. BEYER, in a field survey on MARCH 24, 19 98, do hereby certify that under requirements of P.A. 74, Michigan P.A. of 1970, the corner points mentioned in lines 1 and 2 above were in conformance with regulations and rules therefore as required in the current manual of survey instructions of the United States Department of the Interior, Bureau of Land Management or by decree of a Court of Law and/or that the corner points mentioned in lines 3, 4 and 5 above were in conformance with the rules of the Michigan Board of Land Surveyors or by Decree of a Court of Law; established, re-established, monumented, re-monumented, recovered, found as expressed below:

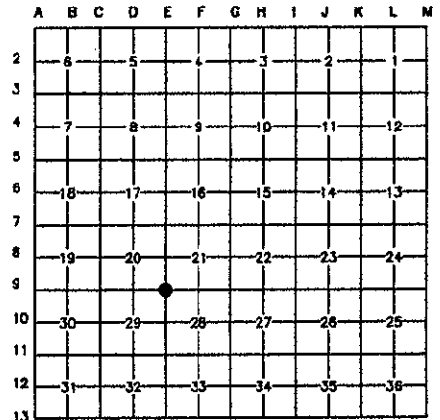

NE CORNER SECTION 29

A. Description of original monument and accessories and/or subsequent restoration:

- G.L.O. - 1819
- 23" W.O. N 36° E 58 LKS (38.3')
- 28" D.O. S 27° E 44 LKS (29.0')
- C.S. WOODARD - 1887
- CORNER IDENTIFIED AND REESTABLISHED
- 30" ELM S 49° E 0.83 (54.8')
- 12" HICKORY S 18° E 0.59 1/2 (39.3')
- SET STAKE, TILE, AND STONE

Continued on Back

B. Description of corner evidence and/or method applied in restoring or reestablishing corner:

FOUND 3/4" IRON PIPE AT ROAD SURFACE. WITNESSED, PULLED AND RESET WITH 3/4"x18" IRON PIPE IN MONUMENT BOX.
FOUND EIGHT (8) REMAINING WITNESSES.
PLACED ALUMINUM REMON CAP STAMPED '41092'.

C. Description of monument for corner and accessories established to perpetuate locating the position of the corner:

- 3/4" IRON PIPE WITH ALUMINUM REMON CAP STAMPED '41092', INSIDE MONUMENT BOX.
- (2) 26" HICKORY S 14° E 39.45' NAIL/TAG W SIDE
- (9) 10" ELM S 60° E 72.45' NAIL/TAG NE SIDE
- (10) N. EDGE PAVEMENT NORTH 12.9'
- (11) S. EDGE PAVEMENT SOUTH 11.7'
- (13) 24" MAPLE N 81° E 151.04' NAIL/TAG SW SIDE
- (14) 10" ELM N 59° W 70.57' NAIL/TAG SW SIDE
- (7) 3/4" IRON PIPE S 04° W 33.04' A-H CAP #37271
- (15) MCI UNDERGRND MARKER S 77° W 104.79'
- (16) 18" MAPLE N 82° E 164.50' SET NAIL/TAG S SIDE
- (17) 11" ELM CLUMP S 80° W 115.07' SET NAIL/TAG N SIDE



AFTER CAREFUL EXAMINATION OF RECORD DOCUMENTATION AND FIELD OBSERVATIONS, I BELIEVE THIS POINT SHOULD BE ACCEPTED AS A CAREFUL AND FAITHFUL PERPETUATION OF THE POSITION OF THE ORIGINAL CORNER. THIS CORNER WAS RATIFIED BY THE PEER REVIEW COMMITTEE IN NOVEMBER, 1998.

Signed by Lori E. Beyer Date Dec 23, 1998
Surveyor's Michigan License No. 41092

APPROVED
DATE 11-5-98
CO. REP. Hx

COPY

W.J. Armstrong - RLS 2444 - February 1933 - Washtenaw County Road Commission Grid Book
 Found Woodard's stake inside a 4" Tile with stones around it. Reset with a 1 1/2" x 42" Iron Pipe and placed 4 bricks around it.

1) 6" Elm	S 73° E	92.85'
2) 18" Hickory	S 18 1/2° E	39.75'
3) 8" Elm	S 67° W	56.0'
4) 8" Elm	S 75 1/2° W	85.23'

Allen R. Rentschler - RLS 15411 - May 1977 - L.C.R.C. Liber 4 Page 317
 Found 1 1/2" Iron Pipe and raised with 1" Iron Pipe

2) 20" Hickory	S 20° E	40.5'
5) 16" Maple	N 60° E	61.5'
6) Corner Post	N 45° W	44.5'

Robert A. Campbell, Jr. - RLS 13028 - September 1983 - L.C.R.C. Liber 6 Page 318
 Found 3/4" Iron Pipe. Witnessed and pulled for construction of Textile Road. Reset with 3/4" x 18" Iron Pipe at road surface.


2) 28" Hickory	S 15° E	40.15'	Set nail E. side
6) Corner F. Post	N 39° W	44.8'	
7) 3/4" Iron Pipe	S 03° W	33.06'	
8) 1" Hickory	S 55° W	42.2'	
9) 5" Elm	S 60° E	73.32'	Set nail NE side
10) N. Edge Pvmt	North	12.6'	
11) S. Edge Pvmt	South	11.4'	

Kevin M. Anderson - PLS 37269 - 1992 - Washtenaw County Road Commission Field Book F-12
 Found 3/4" WCRC capped Iron Pipe #13028

2) 28" Hickory	S 15° E	40.10'	
6) Corner Post	N 45° W	44.8'	
8) 1" Hickory (Dead)	S 55° W	42.2'	
9) 5" Elm	S 60° E	73.19'	
10) N. Edge Pvmt	North	12.4'	
11) S. Edge Pvmt	South	11.6'	
12) 8" Elm	S 72° E	73.24'	Set nail
13) 24" Maple	N 80° E	151.50'	Fnd nail
14) 8" Elm	N 59° W	70.60'	Fnd nail

Robert J. Jagow, Jr. - PS 33137 - May 1995 - L.C.R.C. Liber 8 Page 182
 Found 1/2" Capped Iron Pipe

2) 30" Shagbark Hickory	S 18° E	39.70'
15) MCI Underground Marker	S 77° W	104.54'
14) 10" Elm	N 63° W	70.78'
13) 30" Maple	N 78° E	151.40'

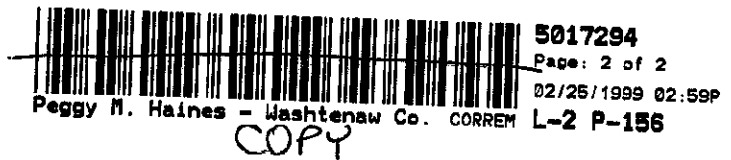

**SURVEY &
 REMONUMENTATION**

NOV 02 1999

SECTION