

SURVEY & REMONUMENTATION

NOV 02 1999

LAND CORNER RECORDATION CERTIFICATE
Filing Requirement of Act 74, Mich. P.A. 1970

SECTION

For corners in

WASHTENAW
(County)

Located In: Corner Code #

1. Public Land Survey T 3S R 6E E-12
PITTSFIELD TWP T _____ R _____
T _____ R _____
T _____ R _____


2. Property controlling S _____ T _____ R _____
in Section S _____ T _____ R _____

3. Miscellaneous S _____ T _____ R _____
Property in Sec. S _____ T _____ R _____

4. Lot No. _____, Recorded Plat _____

5. Private Claims _____

5017296
Page: 1 of 2
02/25/1999 02:59P
L-2 P-159
Peggy M. Haines - Washtenaw Co. CORREM
COPY
Register of Deeds Stamp & File Number

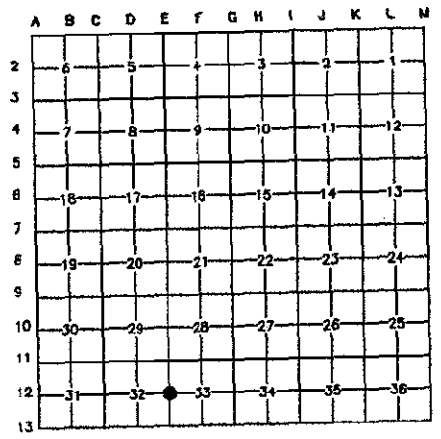

I, LORI E. BEYER, in a field survey on MARCH 24, 19 98, do hereby certify that under requirements of P.A. 74, Michigan P.A. of 1970, the corner points mentioned in lines 1 and 2 above were in conformance with regulations and rules therefore as required in the current manual of survey instructions of the United States Department of the Interior, Bureau of Land Management or by decree of a Court of Law and/or that the corner points mentioned in lines 3, 4 and 5 above were in conformance with the rules of the Michigan Board of Land Surveyors or by Decree of a Court of Law; established, re-established, monumented, re-monumented, recovered, found as expressed below:

E 1/4 CORNER SECTION 32

- A. Description of original monument and accessories and/or subsequent restoration:
- G.L.O. - 1819
 - 26" W.O. S 06' W 44 LKS (29.0')
 - 23" D.O. N 30' W 47 LKS (31.0')
 - C.S. WOODARD - 1887
CORNER NOT FOUND BUT REESTABLISHED BY CAREFUL LINE AND MEASUREMENT
 - 20" W.O. N 07' E 0.36 (23.8')
 - 24" B.O. N 47' E 0.04 1/2 (3.0')
 - 1 1/4" PIPE AND STONES

Continued on Back

- B. Description of corner evidence and/or method applied in restoring or reestablishing corner:
- FOUND 1"x36" IRON PIPE 20" BELOW SURFACE.
 - FOUND FOUR (4) REMAINING WITNESSES.
 - SET 3/4"x18" IRON PIPE OVER 1" I.P. AND PLACED ALUMINUM REMON CAP STAMPED '41092'.

- C. Description of monument for corner and accessories established to perpetuate locating the position of the corner:
- 3/4" IRON PIPE WITH ALUMINUM REMON CAP STAMPED '41092' AT GROUND SURFACE, OVER 1" IRON PIPE.
 - (4) STUMP N 86° W 54.2'
 - (5) OAK STUMP N 04° W 8.0'
 - (6) 12" TWIN CHERRY S 04° W 28.91' SET NAIL/TAG NW SIDE
 - (7) 10" HICKORY N 80° W 11.78' SET NAIL/TAG N SIDE
 - (8) 6" HICKORY N 39° W 14.17' SET NAIL/TAG NE SIDE
 - (9) 10" HICKORY N 03° E 20.15' SET NAIL/TAG E SIDE

AFTER CAREFUL EXAMINATION OF RECORD DOCUMENTATION AND FIELD OBSERVATIONS, I BELIEVE THIS POINT SHOULD BE ACCEPTED AS THE BEST AVAILABLE EVIDENCE OF THE POSITION OF THE ORIGINAL CORNER.
THIS CORNER WAS RATIFIED BY THE PEER REVIEW COMMITTEE IN NOVEMBER, 1998.



Signed by Lori E. Beyer
Surveyor's Michigan License No. 41092

Date Dec 23, 1998

APPROVED
DATE 11-9-98
CO. REP. [Signature]

COPY

Continued from Section A:

K.B. Pester, R. Barnes - December 1932 - Washtenaw County Road Commission Grid Book

Found 1" Iron Pipe and stones. Put 4" bricks around pipe.

1) 30" W. Oak	N 09° E	24.05'
2) 8" W. Oak	N 69° E	33.83'
3) 15" B. Oak	S 60° E	26.5'
4) 15" Cherry	N 89° W	54.4'

Thomas L. Sutherland - RLS 24620 - July 1979 - L.C.R.C. Liber 5 Page 221

Found 1" Iron Pipe

4) 24" Stump	N 89° W	54.4'	
5) 18" Oak	N 20° W	7.76'	Nail
6) 6" Cherry	South	30.9'	
7) 5" Hickory	N 87° W	11.7'	

Robert A. Campbell, Jr. - RLS 13028 - 1986 - Washtenaw County Road Commission Field Book.

Found 1" Iron Pipe

4) 24" Stump	N 89° W	54.4'
5) 18" Oak	N 20° W	7.76'
6) 6" Cherry	South	30.9'
7) 3" Hickory	N 87° W	11.7'



SURVEY &
REMONUMENTATION

NOV 02 1999

SECTION