

SURVEY & REMONUMENTATION

LAND CORNER RECORDATION CERTIFICATE
Filing Requirement of Act 74, Mich. P.A. 1970

NOV 02 1999

For corners in WASHTENAW (County)

Located In: _____ Corner Code # _____

1. Public Land Survey T 3S R 6E E-13
PITTSFIELD TWP T _____ R _____
T _____ R _____
T _____ R _____

2. Property controlling S _____ T _____ R _____
in Section S _____ T _____ R _____


3. Miscellaneous S _____ T _____ R _____
Property in Sec. S _____ T _____ R _____

4. Lot No. _____, Recorded Plat _____

5. Private Claims _____

SECTION

5017297
Page: 1 of 2
02/26/1999 02:59P
L-2 P-161
Peggy M. Haines - Washtenaw Co. CORREM
COPY

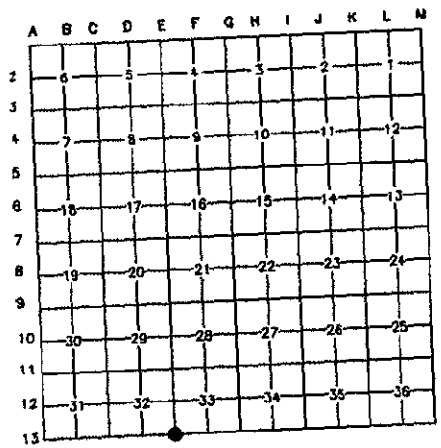

I, LORI E. BEYER, in a field survey on MARCH 24, 19 98, do hereby certify that under requirements of P.A. 74, Michigan P.A. of 1970, the corner points mentioned in lines 1 and 2 above were in conformance with regulations and rules therefore as required in the current manual of survey instructions of the United States Department of the Interior, Bureau of Land Management or by decree of a Court of Law and/or that the corner points mentioned in lines 3, 4 and 5 above were in conformance with the rules of the Michigan Board of Land Surveyors or by Decree of a Court of Law; established, re-established, monumented, re-monumented, recovered, found as expressed below:

SE CORNER SECTION 32

A. Description of original monument and accessories and/or subsequent restoration:

G.L.O. - 1815
18" W.O. N 20° W 47 LKS (31.0')
36" W.O. S 16° E 49 LKS (32.3')

C.S. WOODARD - 1887
CORNER NOT FOUND BUT REESTABLISHED BY CAREFUL LINE AND MEASUREMENT
SE COR FOUNDATION HSE N 44° W 1.92 (126.7')
10" SPRUCE N 72° W 1.82 (120.1')
SET LONG STONE AND BRICK

Continued on Back

B. Description of corner evidence and/or method applied in restoring or reestablishing corner:

FOUND 3/4" IRON PIPE WITH CAP #13028 INSIDE MONUMENT BOX AT PAVEMENT SURFACE AT CENTERLINE OF BEMIS ROAD, EAST OF MOON ROAD.
FOUND SEVEN (7) REMAINING WITNESSES.
PLACED ALUMINUM REMON CAP OVER 3/4" IRON PIPE - STAMPED WITH '41092'.

C. Description of monument for corner and accessories established to perpetuate locating the position of the corner:

3/4" IRON PIPE WITH ALUMINUM REMON. CAP STAMPED '41092' INSIDE MONUMENT BOX AT PAVEMENT SURFACE AT CENTERLINE OF BEMIS ROAD EAST, OF MOON ROAD.

(1) FOUND NAIL IN STUMP	S 74° E	129.06'	
(2) 24" SPRUCE	N 65° W	141.85'	
(3) SE COR HOUSE	N 40° W	125.4'	
(5) 1 1/2" IRON PIPE	S 04° W	33.24'	
(7) TELE. POLE	S 55° W	45.50'	NAIL/TAG S FACE
(8) 14" SPRUCE	N 36° W	76.4'	
(9) R.O.W. PIPE	N 05° E	33.32'	
(10) UTILITY POLE	N 82° E	128.30'	MAG NAIL/TAG S FACE
NE COR SEC 5, T4S, R6E	WEST	217.7'	



AFTER CAREFUL EXAMINATION OF RECORD DOCUMENTATION AND FIELD OBSERVATIONS, I BELIEVE THIS POINT SHOULD BE ACCEPTED AS THE BEST AVAILABLE EVIDENCE OF THE POSITION OF THE ORIGINAL CORNER.
THIS CORNER WAS RATIFIED BY THE PEER REVIEW COMMITTEE IN NOVEMBER, 1998.

Signed by Lori E. Beyer Date Dec 23, 1998
Surveyor's Michigan License No. 41092

FORM APPROVED BY MICHIGAN STATE BOARD OF LAND SURVEYORS, JAN. 28, 1971
REVISED MAY 14, 1975
REVISED JAN., 1983

APPROVED
DATE 11-9-98
CO. REP. Ky

COPY

E-13

Continued from Section A:

W.J. Armstrong - December 1932 - Washtenaw County Road Commission Grid Book

Found 1 1/2" Iron Shaft with brick and stones around it. Did not reset.

- | | | |
|------------------|-------------|---------|
| 1) 20" W. Oak | S 74° E | 128.33' |
| 2) 6" Spruce | N 68° W | 141.75' |
| 3) SE Cor. House | N 40 1/2° W | 125.4' |
| 4) 6" Maple | N 03° W | 98.15' |
| 5) ROW Pipe | | |
| 6) ROW Pipe | | |

DMW, HJ, JS - November 1965 - Washtenaw County Road Commission Grid Book Handwritten Notes

Did not list monument

- | | | |
|---------------|---------|---------|
| 1) 30" W. Oak | S 74° E | 128.33' |
| 7) T. Pole | S 53° W | 46.25' |
| 8) 3" Spruce | N 37° W | 76.5' |

John Oliver, RLS 19840 - July 1973 - LCRC Liber 3 Page 195

Found 5/8" Iron Pipe

- | | | |
|------------------|-------------|---------|
| 1) 36" W. Oak | S 74° E | 128.33' |
| 2) 7" Spruce | N 68° W | 141.75' |
| 3) SE Cor. House | N 40 1/2° W | 125.4' |
| 8) 6" Spruce | N 37° W | 76.5' |
| 7) MBT Pole | S 53° W | 45.62' |

Robert A. Campbell, Jr., RLS 13028 - November 1982 - LCRC Liber 6 Page 259

Found 1/2" Iron Pipe over 1 1/2" Iron Shaft 17" down, surrounded by brick. Raised to surface with 3/4" x 12" Iron Pipe in monument box over 1 1/2" Iron Shaft.

- | | | |
|--------------------|---------|-------------------------|
| 1) 30" Oak | S 70° E | 128.5' |
| 2) 19" Spruce | N 65° W | 141.7' |
| 3) SE Cor. House | N 39° W | 125' (through bushes) |
| 5) 1 1/2" ROW Iron | S 04° W | 33.20' |
| 7) Telephone Pole | S 55° W | 45.56' Fnd nail SE side |
| 8) 8" Spruce | N 34° W | 76.3' |
| 9) 1/2" ROW Iron | N 06° E | 33.31' |

Allen R. Rentschler, RLS 15411 - November 1986 - PA 132 Certificate Liber 2306, Page 743

Shows Found Iron - No witnesses listed



5017297

Page: 2 of 2

02/25/1999 02:59P

Peggy M. Haines - Washtenaw Co. CORREM L-2 P-162

COPY

SURVEY &
REMONUMENTATION

NOV 02 1999

SECTION