

**SURVEY & REMONUMENTATION**

**LAND CORNER RECORDATION CERTIFICATE**  
Filing Requirement of Act 74, Mich. P.A. 1970

NOV 02 1999

For corners in

WASHTENAW  
(County)

Located In: \_\_\_\_\_ Corner Code # \_\_\_\_\_

1. Public Land Survey T 3S R 6E F-9  
PITTSFIELD TWP T \_\_\_\_\_ R \_\_\_\_\_  
T \_\_\_\_\_ R \_\_\_\_\_  
T \_\_\_\_\_ R \_\_\_\_\_

2. Property controlling S \_\_\_\_\_ T \_\_\_\_\_ R \_\_\_\_\_  
in Section S \_\_\_\_\_ T \_\_\_\_\_ R \_\_\_\_\_

3. Miscellaneous S \_\_\_\_\_ T \_\_\_\_\_ R \_\_\_\_\_  
Property in Sec. S \_\_\_\_\_ T \_\_\_\_\_ R \_\_\_\_\_


4. Lot No. \_\_\_\_\_, Recorded Plat \_\_\_\_\_

5. Private Claims \_\_\_\_\_

SECTION

5017298  
Page: 1 of 2  
02/25/1999 02:59P  
Peggy M. Haines - Washtenaw Co. CORREM L-2 P-163  
COPY  
Register of Deeds Stamp & File Number

I, LORI E. BEYER, in a field survey on MARCH 24, 19 98, do hereby certify that under requirements of P.A. 74, Michigan P.A. of 1970, the corner points mentioned in lines 1 and 2 above were in conformance with regulations and rules therefore as required in the current manual of survey instructions of the United States Department of the Interior, Bureau of Land Management or by decree of a Court of Law and/or that the corner points mentioned in lines 3, 4 and 5 above were in conformance with the rules of the Michigan Board of Land Surveyors or by Decree of a Court of Law; established, re-established, monumented, re-monumented, recovered, found as expressed below:

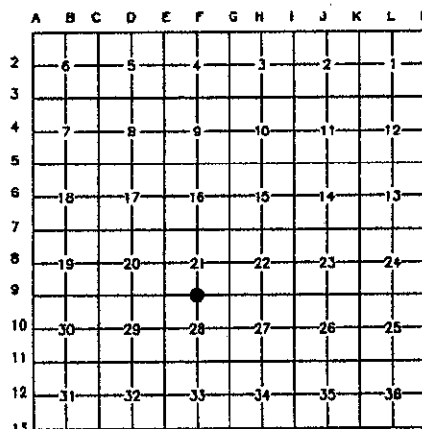

N 1/4 CORNER SECTION 28

A. Description of original monument and accessories and/or subsequent restoration:

- G.L.O. - 1819  
24" W.O. N 47° E 14 LKS (9.2')  
13" HICKORY S 67° W 16 LKS (10.6')
- C.S. WOODARD - 1887  
CORNER IDENTIFIED AND REESTABLISHED  
28" ELM NORTH 6.28 1/2 (414.8')  
14" ELM N 86° E 5.87 (387.4')  
SET IRON STAKE, TILE AND STONE

Continued on Back

B. Description of corner evidence and/or method applied in restoring or reestablishing corner:

FOUND 3/4" IRON PIPE WITH SMASHED TOP. REMOVED AND FOUND 1 1/2" IRON PIPE BELOW WITH BRICKS.  
FOUND FIVE (5) REMAINING WITNESSES.  
SET 3/4"x18" IRON PIPE OVER 1 1/2" I.P. AND PLACED ALUMINUM REMON CAP STAMPED '41092'.

C. Description of monument for corner and accessories established to perpetuate locating the position of the corner:

3/4" IRON PIPE WITH ALUMINUM REMON CAP STAMPED '41092' AT GROUND SURFACE, OVER 1" IRON PIPE.

- |                     |         |        |                       |
|---------------------|---------|--------|-----------------------|
| (4) 16" HICKORY     | N 07° E | 99.79' | SET NAIL/TAG S SIDE   |
| (5) T. POLE         | N 30° W | 37.32' | SET NAIL/TAG E SIDE   |
| (7) 12" MAPLE       | N 36° E | 49.25' | SET NAIL/TAG W SIDE   |
| (8) WOOD FENCE POST | N 07° E | 33.14' | TO NAIL W/ CAP #12024 |
| (9) POWER POLE      | S 42° W | 34.83' | SET NAIL/TAG SE SIDE  |



AFTER CAREFUL EXAMINATION OF RECORD DOCUMENTATION AND FIELD OBSERVATIONS, I BELIEVE THIS POINT SHOULD BE ACCEPTED AS A CAREFUL AND FAITHFUL PERPETUATION OF THE POSITION OF THE ORIGINAL CORNER.  
THIS CORNER WAS RATIFIED BY THE PEER REVIEW COMMITTEE IN NOVEMBER, 1998.

Signed by Lori E. Beyer Date Dec 23, 1998  
Surveyor's Michigan License No. 41092

APPROVED  
DATE 11-5-98  
CO. REP. [Signature]

COPY

W.J. Armstrong - RLS 2444 - February 1933 - Washtenaw County Road Commission Grid Book  
Found Iron Bar inside a 3" tile with rocks around it. Reset with a 1 1/2" x 42" Iron Pipe and put  
4 bricks around it.

|               |             |         |
|---------------|-------------|---------|
| 1) 20" Elm    | North       | 415.6'  |
| 2) 30" Elm    | N 86° E     | 388.65' |
| 3) 24" Elm    | S 82 1/2° W | 181.1'  |
| 4) 8" Hickory | N 01 1/2° E | 100.45' |

Douglas W. Hooth - MDOT Surveyor - May 1976 - L.C.R.C. Liber 4 Page 139  
Found 1/2" Iron Pipe

|                    |         |        |            |
|--------------------|---------|--------|------------|
| 5) Telephone Pole  | N 40° W | 37.48' | MDSH&T Tag |
| 6) Telephone Pole  | S 45° W | 33.46' |            |
| 7) 6" Maple        | N 20° E | 49.39' |            |
| 8) Wood Fence Post | North   | 33.00' |            |

Kevin M. Anderson - PS 37269 - 1992 - Washtenaw County Road Commission Field Book F-12  
Found 1/2" Iron Pipe.

|                    |             |        |
|--------------------|-------------|--------|
| 4) 18" Hickory     | N 01 1/2° E | 100.5' |
| 5) T. Pole         | N 40° W     | 37.32' |
| 7) 10" Maple       | N 20° E     | 49.5'  |
| 8) Wood Fence Post | North       | 33.14' |
| 9) Power Pole      | S 39° W     | 34.14' |
| 10) 10" Hickory    | S 65° W     | 61.5'  |



5017298

Page: 2 of 2

02/25/1999 02:59P

Peggy M. Haines - Washtenaw Co. CORREM L-2 P-164

COPY

SURVEY &  
REMONUMENTATION

NOV 02 1999

SECTION