

SURVEY & REMONUMENTATION

NOV 02 1999

LAND CORNER RECORDATION CERTIFICATE
Filing Requirement of Act 74, Mich. P.A. 1970

SECTION

For corners in

WASHTENAW
(County)


Located In: Corner Code #

1. Public Land Survey T 3S R 6E F-13
PITTSFIELD TWP T _____ R _____
T _____ R _____
T _____ R _____

2. Property controlling S _____ T _____ R _____
in Section S _____ T _____ R _____
3. Miscellaneous S _____ T _____ R _____
Property in Sec. S _____ T _____ R _____

4. Lot No. _____, Recorded Plat _____
5. Private Claims _____

5017300
Page: 1 of 2
02/25/1999 02:59P
L-2 P-167
Peggy R. Haines - Washtenaw Co. CORREM
Stamp & File Number

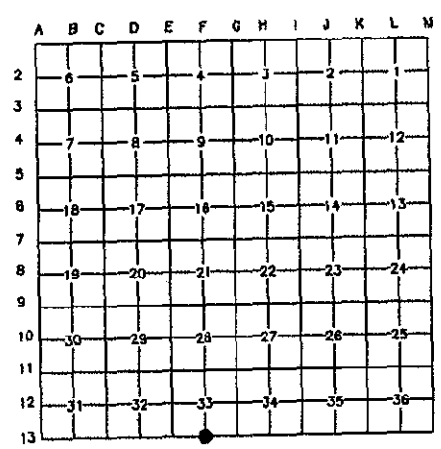

I, LORI E. BEYER, in a field survey on MARCH 24, 19 98, do hereby certify that under requirements of P.A. 74, Michigan P.A. of 1970, the corner points mentioned in lines 1 and 2 above were in conformance with regulations and rules therefore as required in the current manual of survey instructions of the United States Department of the Interior, Bureau of Land Management or by decree of a Court of Law and/or that the corner points mentioned in lines 3, 4 and 5 above were in conformance with the rules of the Michigan Board of Land Surveyors or by Decree of a Court of Law; established, re-established, monumented, re-monumented, recovered, found as expressed below:

S 1/4 CORNER SECTION 33

A. Description of original monument and accessories and/or subsequent restoration:

- G.L.O. - 1815
W.O. 30" S 46° E 54 LKS (33.6')
W.O. 15" N 82° W 33 LKS (21.8')
- C.S. WOODARD - 1887
CORNER IDENTIFIED AND REESTABLISHED
20" B.O. S 72° E 0.29 (19.1')
18" W.O. S 31° W 0.70 (46.2')
STONE IN PLACE, DID NOT DISTURB

Continued on Back

B. Description of corner evidence and/or method applied in restoring or reestablishing corner:

FOUND 3/4" IRON PIPE WITH W.C.R.C. CAP #13028 INSIDE MONUMENT BOX AT CL INTERSECTION OF BEMIS ROAD AND FOSDICK ROAD.
FOUND SEVEN (7) REMAINING WITNESSES.
PLACED ALUMINUM REMON CAP OVER 3/4" IRON PIPE - STAMPED WITH '41092'.

C. Description of monument for corner and accessories established to perpetuate locating the position of the corner:

3/4" IRON PIPE WITH ALUMINUM REMON. CAP STAMPED WITH '41092' INSIDE MONUMENT BOX AT CL INTERSECTION OF BEMIS ROAD AND FOSDICK ROAD.

- | | | | |
|-----------------------|---------|---------|----------------------|
| (1) 37" HICKORY | S 21° W | 104.67' | SET NAIL/TAG E SIDE |
| (2) 24" MAPLE | S 33° W | 67.80' | SET NAIL/TAG E SIDE |
| (3) 28" MAPLE | S 51° W | 66.47' | SET NAIL NW SIDE |
| (5) NE COR SCHOOL | S 37° W | 151.1' | |
| (6) POWER POLE | N 52° E | 45.61 | SET NAIL/TAG NW SIDE |
| (8) 8"-12" TW HICKORY | S 34° E | 44.48 | SET NAIL/TAG NE SIDE |
| (9) 30" WILLOW | S 40° W | 94.76 | SET NAIL/TAG S SIDE |
| (11) 10" MAPLE | S 64° W | 86.31 | SET NAIL/TAG S SIDE |
| N 1/4 COR SEC 4 | WEST | 201.53' | 3/4" IP IN MON. BOX |



AFTER CAREFUL EXAMINATION OF RECORD DOCUMENTATION AND FIELD OBSERVATIONS, I BELIEVE THIS POINT SHOULD BE ACCEPTED AS THE BEST AVAILABLE EVIDENCE OF THE POSITION OF THE ORIGINAL CORNER.
THIS CORNER WAS RATIFIED BY THE PEER REVIEW COMMITTEE IN NOVEMBER, 1998.

Signed by Lori E. Beyer Date Dec 23, 1998
Surveyor's Michigan License No. 41092

PROVED
DATE 11-9-98
REP. [Signature]

COPY

F-13

Continued from Section A:

K.B. Pester, W.C. Lowe - November 1932 - Washtenaw County Road Commission Grid Book

Found State Monument

- | | | |
|-------------------|-------------|--------|
| 1) 30" Hickory | S 17° W | 105.8' |
| 2) 8" Maple | S 28° W | 67.83' |
| 3) 24" Maple | S 45 1/2° W | 65.6' |
| 4) 24" Apple | N 33° W | 68.1' |
| 5) NE Cor. School | S 34° W | 151.2' |

Charles C. Wilson, RLS 13604 - July 1971 - LCRC Liber 1 Page 169

Found 3/4" Iron Pipe

- | | | |
|-------------------|-------------|-------|
| 6) Power Pole | N 49° E | 45.8' |
| 7) Telephone Pole | S 62° E | 70.3' |
| 8) 24" Maple | S 45 1/2° W | 65.6' |

Howard Taft, RLS 12032 - August 1976 - PA 132 Certificate Liber 1562 Page 339

Found 3/4" Iron Pipe

- | | | |
|-------------------|---------|--------|
| 1) 36" Hickory | S 17° W | 105.8' |
| 2) 24" Maple | S 28° W | 67.8' |
| 3) 32" Maple | S 45° W | 65.6' |
| 4) NE Cor. School | S 34° W | 151.6' |

Robert A. Campbell, Jr., RLS 13028 - November 1982 - LCRC Liber 6 Page 260

Found 1/2" Iron Pipe over 4" monument with brass cap. Raised to road surface with 3/4" Iron Pipe in monument box over the 4" brass capped monument.

- | | | |
|----------------------|---------|-------------------------|
| 1) 37" Hickory | S 19° W | 105.5' |
| 2) 21" Maple | S 31° W | 68.0' |
| 3) 26" Maple | S 49° W | 66.2' |
| 5) NE Cor. School | S 36° W | 151.1' |
| 6) Power Pole | N 51° E | 45.61' Set nail NW side |
| 8) 5"-8" Tw. Hickory | S 35° E | 44.0' |
| 9) 5" Willow | N 53° W | 95.4' |

Craig A. Eckfeld, RLS 33135 - April 1991 - PA 132 Certificate Liber 2595 Page 154

Found 3/4" Iron Pipe with WCRC cap inside monument box.

- | | | |
|-----------------------|---------|--------------|
| 8) 8"-12" Tw. Hickory | S 35° E | 44.36' |
| 3) 28" Maple | S 45° W | 66.6' |
| 9) 18" Willow | N 45° W | 95.2' |
| 10) Utility Pole | N 70° W | 146.77' Nail |
| 6) Utility Pole | N 45° E | 45.22' Nail |



SURVEY &
REMONUMENTATION

NOV 02 1999

SECTION