

SURVEY & REMONUMENTATION

MAR 09 1998

RECORDED
WASHTENAW COUNTY, MI

JAN 22 8 31 AM '98

SECTION

LAND CORNER RECORDATION CERTIFICATE
Filing Requirement of Act 74, Mich. P.A. 1970

For corners in

WASHTENAW (County)	Located In:	Corner Code #
1. Public Land Survey PITTSFIELD	T 3S R 6E	H-11
	T _____ R _____	_____
	T _____ R _____	_____
	T _____ R _____	_____
2. Property controlling in Section	S _____ T _____ R _____	_____
	S _____ T _____ R _____	_____
3. Miscellaneous Property in Sec.	S _____ T _____ R _____	_____
	S _____ T _____ R _____	_____
4. Lot No. _____, Recorded Plat _____		
5. Private Claims _____		

PEGGY A. HAINES
COUNTY CLERK/REGISTER

- COPY -

- COPY -

Liber 00002 Page 0053 RM

Register of Deeds Stamp & File Number

I, LORI E. BEYER, in a field survey on NOVEMBER 26, 19 97, do hereby certify that under requirements of P.A. 74, Michigan P.A. of 1970, the corner points mentioned in lines 1 and 2 above were in conformance with regulations and rules therefore as required in the current manual of survey instructions of the United States Department of the Interior, Bureau of Land Management or by decree of a Court of Law and/or that the corner points mentioned in lines 3, 4 and 5 above were in conformance with the rules of the Michigan Board of Land Surveyors or by Decree of a Court of Law; established, re-established, monumented, re-monumented, recovered, found as expressed below:

NOTE: Not more than 4 corners, all in the same town and range, may be recorded on this certificate

A. Description of original monument and accessories and/or subsequent restoration:

G.L.O. - 1819 FIELD NOTES

SET POST

16" W.O. N 26° E 11.22'
17" B.O. S 75° W 48.18'

Continued on Back

B. Description of corner evidence and/or method applied in restoring or reestablishing corner:

FOUND 3/4" IRON PIPE BETWEEN 2 20" OAKS. DUG 1' DOWN BUT BASE OF IRON IS BETWEEN LARGE ROOTS. CANNOT DIG FURTHER WITHOUT CUTTING ROOTS. SET ALUMINUM REMONUMENTATION CAP STAMPED '41092' ON TOP OF IRON PIPE.

C. Description of monument for corner and accessories established to perpetuate locating the position of the corner:

FOUND 3/4" IRON PIPE. PLACED ALUMINUM REMONUMENTATION CAP STAMPED '#41092' ON TOP OF IRON PIPE.

(5) 24" OAK N 25° E 2.07' FD NAIL
(6) 18" TW. OAK S 54° E 18.87' FD PK NAIL
(7) 15" OAK S 50° W 2.87' FD MAG NAIL
(8) 6" OAK S 11° E 20.64' FD PK NAIL
(9) 22" OAK N 85° W 21.55' FD PK NAIL

APPROVED

DATE 12/9/97


CO. REP. fx

AFTER CAREFUL EXAMINATION OF RECORD DOCUMENTATION AND FIELD OBSERVATIONS, I BELIEVE THIS POINT SHOULD BE ACCEPTED AS THE BEST AVAILABLE EVIDENCE OF THE POSITION OF THE ORIGINAL CORNER.

Signed by Lori E. Beyer
Surveyor's Michigan License No. 41092

Date Dec 08, 1997

	A	B	C	D	E	F	G	H	I	J	K	L
2	6	5	4	3	2	1						
3												
4	7	8	9	10	11	12						
5												
6	18	17	16	15	14	13						
7												
8	19	20	21	22	23	24						
9												
10	30	29	28	27	26	25						
11												
12	31	32	33	34	35	36						
13												

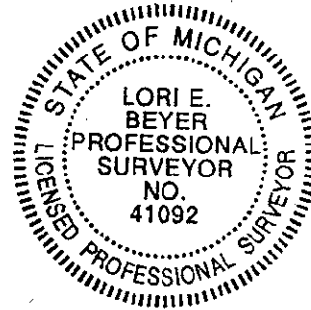

- COPY -

Paragraph A Continued:

H. Goodwin - July 1947

Washtenaw County Road Commission - Grid Book

Found a mound of stones around an old 3" white clay tile.

Reset with 3/4" x 16" iron pipe in the tile.

- (1) 4" HICKORY S 10° E 8.2'
- (2) 14" R. OAK S 12° E 10.0'
- (3) 4" W. OAK NORTH 8.9'
- (4) FENCE RUNS SOUTH FROM THE CORNER IN FENCE LINE E-W

Allen R. Rentschler, RLS #15411 - July 1971

Washtenaw County Records - P.A. 132 Certificate L. 1369 Pg. 381, and Washtenaw

County Records - L.C.R.C. L. 1 Pg. 171

Found 1" Iron Pipe

- (5) 12" OAK N 60° E 2.0'
- (6) 12" TW. OAK S 50° E 20.0'
- (7) 15" OAK S 60° W 3.0'