

APPROVED

DATE 9-23-96

CO. REP. K/A

LAND CORNER RECORDATION CERTIFICATE  
Filing Requirement of Act 74, Mich. P.A. 1970

RECORDED  
WASHTENAW COUNTY, MI  
FEB 18 9 10 AM '97  
PEGGY M. HAINES  
COUNTY CLERK/REGISTRAR

For corners in

Washtenaw  
(County)

Located In:

Corner Code ##

- |                                    |                         |             |
|------------------------------------|-------------------------|-------------|
| 1. Public Land Survey              | T <u>3S</u> R <u>6E</u> | <u>I-13</u> |
|                                    | T _____ R _____         | _____       |
|                                    | T _____ R _____         | _____       |
|                                    | T _____ R _____         | _____       |
| 2. Property Controlling in Section | S _____ T _____ R _____ | _____       |
|                                    | S _____ T _____ R _____ | _____       |
| 3. Miscellaneous Property in Sec.  | S _____ T _____ R _____ | _____       |
|                                    | S _____ T _____ R _____ | _____       |

Liber 00001 Page 0609am

Register of Deeds Stamp & File Number

4. Lot No. \_\_\_\_\_, Recorded Plat \_\_\_\_\_
5. Private Claims \_\_\_\_\_

	A	B	C	D	E	F	G	H	I	J	K	L	M
2	6		5		4		3		2		1		
3													
4	7		8		9		10		11		12		
5													
6	18		17		16		15		14		13		
7													
8	19		20		21		22		23		24		
9													
10	30		29		28		27		26		25		
11													
12	31		32		33		34		35		36		
13													

I, Todd D. Shelly, in a field survey on 3-22, 19 96, do hereby certify that under requirements of P.A. 74, Michigan P.A. of 1970, the corner points mentioned in lines 1 and 2 above were in conformance with regulations and rules therefore as required in the current manual of survey instructions of the United States Department of the Interior, Bureau of Land Management or by a decree of a Court of Law and/or that the corner points mentioned in lines 3, 4 and 5 above were in conformance with the rules of the Michigan Board of Land Surveyors or by a Decree of a Court of Law; established, re-established, monumented; re-monumented, recovered, found as expressed below:

NOTE: Not more than 4 corners, all in the same town and range, may be recorded on this certificate.

A. Description of original monument and accessories and/or subsequent restoration:  
See back of sheet.

B. Description of corner evidence found and/or method applied in restoring or reestablishing corner:  
Found 3/4" IP with "W.C.R.C." cap in monument box 3-13-96  
See back of sheet.

SURVEY &  
REMONUMENTATION

MAY 05 1997

COMMISSION

C. Description of monument for corner and accessories established to perpetuate locating the position of the corner:  
Found 3/4" IP with "W.C.R.C." cap in monument box. Set aluminum remonumentation cap with PK nail in center over found iron pipe.

- 7) P.P. N30°W 39.22' to nail & RT
- 8) P.P. N76°E 106.64' to nail & RT
- 10) NE corner house #830 S15°E 101.63'
- 11) F.C.I.P. in monument box E'ly 166.88'


COPY

I believe that this point should be accepted as the best available evidence of the position of the original corner.

Signed by Todd D. Shelly  
Surveyor's Michigan License No. 4111

Date Nov 18 1996

FORM APPROVED BY MICHIGAN STATE BOARD OF LAND SURVEYORS, MAY 28, 1971  
41111 REVISED MAY 14, 1975  
EFFECTIVE JAN., 1983

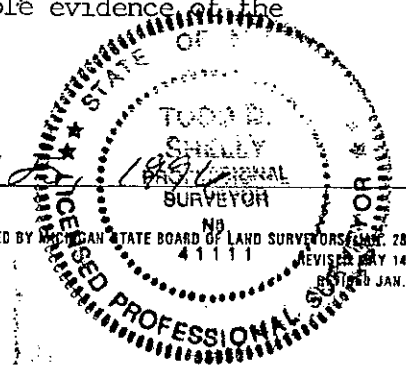

I-13 Witness Summary

11-18-1887	C.S. Woodard		
	Woodard's notes		
	Stake, iron, brick and stone.		
	1) 8" Hickory	N67½°W	74.6'
	2) 8" Hickory	N77¼°E	156.8'
No date	H.H. Atwell		Grid Book
	Iron pipe.		
	3) 12" Hickory	N77½°E	157.1'
	4) 3" Elm	S76½°E	98.75'
	5) 18" Hickory	N85°W	209.5'
	6) S.E. cor. old drw.	N47½°W	91.4'
8-15-1972	N. Fahrner No. 17620		LCRC L.2, P.227
	Monument - raised with I.P.		
	5) 24" Hickory	N79°W	209.5'
	7) P.P.	N34°W	39.3'
	8) P.P.	N77°E	106.7'
	9) Telephone pole	S66°W	66.8'
9-27-1972	N. Fahrner No. 17620		Survey L.1413, P.624
	Found ¾" I.P.		
	5) 24" Hickory	N79°W	209.5'
	6) SE cor. old dwg.	N47°W	91.4'
	7) P.P.	N34°W	39.3'
	8) P.P.	N77°E	106.7'
	9) Telephone pole	S66°W	66.8'
8-21-1976	R, J		Survey Job No. 77-7-21
	Found iron pipe in box.		
	7) P.P.	N30°W	39.17' nail
	8) P.P.	N70°E	106.65' nail
	9) Telephone pole	S60°W	66.81' nail
	10) NE cor. house #830	S15°E	101.70'
12-26-1978	R. Campbell No. 13028		LCRC L.5, P.125
	Set ¾" x 18" I.P. over 4" concrete monument.		Set "Standard Road Box."
	7) P.P.	N30°W	39.22' nail NE side
	8) P.P.	N76°E	106.64' nail NW side
	9) Telephone pole	S68°W	66.82' nail SE side
	11) Telephone pole	S66°E	90.99' nail SW side
1-3-1979	R, J		Job No. 78-12-191
	Found I.P. in box.		
	7) P.P.	N45°W	39.21' nail
	8) P.P.	N70°E	106.70' nail
	9) P.P.	S55°W	66.85' nail
	11) Telephone pole	S55°E	91.12' nail
3-13-1996	Atwell-Hicks, Inc.		Remonumentation
	Found ¾" IP with "W.C.R.C." cap in monument box.		Set aluminum
	Remonumentation cap with PK nail in center over found iron pipe.		
	7) P.P.	N30°W	39.22' to nail & RT
	8) P.P.	N76°E	106.64' to nail & RT
	10) NE corner house #830	S15°E	101.63'
	11) F.C.I.P. in monument box	E'LY	166.88'