

APPROVED
 DATE 9-23-96
 CO. REP. K.A.

LAND CORNER RECORDATION CERTIFICATE
 Filing Requirement of Act 74, Mich. P.A. 1970

RECORDED
 WASHTEENAW COUNTY, MI
 FEB 18 9 11 AM '97
 BEGGY M. HAINES
 COUNTY CLERK/REGISTRAR

For corners in

_____ (County)	Located In:	Corner Code #
Washtenaw	T <u>3S</u> R <u>6E</u>	J-13
1. Public Land Survey	T _____ R _____	_____
	T _____ R _____	_____
	T _____ R _____	_____
	T _____ R _____	_____
2. Property Controlling in Section	S _____ T _____ R _____	_____
	S _____ T _____ R _____	_____
3. Miscellaneous Property in Sec.	S _____ T _____ R _____	_____
	S _____ T _____ R _____	_____

Liber 000001 Page 0613 Am

Register of Deeds Stamp & File Number

4. Lot No. _____, Recorded Plat _____
 5. Private Claims _____

	A	B	C	D	E	F	G	H	I	J	K	L	M
2	6		5		4		3		2		1		
3													
4	7		8		9		10		11		12		
5													
6	18		17		16		15		14		13		
7													
8	19		20		21		22		23		24		
9													
10	30		29		28		27		26		25		
11													
12	31		32		33		34		35		36		
13													

I, Todd D. Shelly, in a field survey on 3-22, 19 96, do hereby certify that under requirements of P.A. 74, Michigan P.A. of 1970, the corner points mentioned in lines 1 and 2 above were in conformance with regulations and rules therefore as required in the current manual of survey instructions of the United States Department of the Interior, Bureau of Land Management or by a decree of a Court of Law and/or that the corner points mentioned in lines 3, 4 and 5 above were in conformance with the rules of the Michigan Board of Land Surveyors or by a Decree of a Court of Law; established, re-established, monumented; re-monumented, recovered, found as expressed below:

NOTE: Not more than 4 corners, all in the same town and range, may be recorded on this certificate.

A. Description of original monument and accessories and/or subsequent restoration:
 See back of sheet.

B. Description of corner evidence found and/or method applied in restoring or reestablishing corner:
 Found 3/4" IP in monument box with unreadable cap 3-13-96.
 See back of sheet.

SURVEY &
 REMONUMENTATION
 MAY 05 1997
 COMMISSION

C. Description of monument for corner and accessories established to perpetuate locating the position of the corner:
 Found 3/4" IP in monument box with unreadable cap. Set aluminum remonumentation cap with PK nail in center over found pipe.


10) U.P.	N75°E	86.05' to nail & RT
12) U.P.	N70°	138.06' to nail & RT
14) Metal Light Pole	N72°E	179.6' to center
18) Telephone riser	S55°E	46.5' to center

COPY

I believe that this point should be accepted as the best available evidence of the position of the original corner.

Signed by Todd D. Shelly
 Surveyor's Michigan License No. 41111

Date Nov 2 1996
 No. _____
 FORM APPROVED BY MICHIGAN STATE BOARD OF LAND SURVEYORS, JAN. 1971
 REVISOR MAR. 1975
 REVISOR MAR. 1983

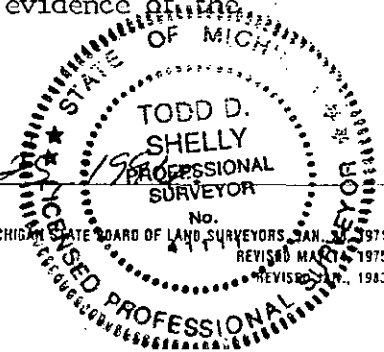

J-13 Witness Summary

11-18-1887 C.S. Woodard

Woodard's notes

Iron bar, brick and stone.

1) 18" Hickory	N55½°W	43.6'
2) 10" Hickory	N63°E	65.3'

No date H.H. Atwell

Grid Book

Iron pipe.

3) 9" Apple	N42½°E	58.8'
4) 9" Apple	N5½°E	71.8'
5) 12" Apple	N18½°W	50.6'
6) 14" Apple	N37½°W	78.0'
7) U.S.G.S. B.M.	S4°W	21.45'

11-13-1964 Phillips

A-H book 688-52

3" steel encased mon. at centerline of grave. No visible 1/4 line fence or occupation

8) SW cor. house #3567	N76°E	326.40'
9) SE cor. house #3461	N68°W	209.60'
10) Spike S. side P.P.	N70°E	89.30'

12-29-1976 N. Fahrner No. 17620

LCRC L.1581, P.609

Found iron pipe.

10) P.P.	N70°E	89.5'
11) Telephone pole	SOUTH	41.7'
12) P.P.	N70°W	138.1'

5-16-1977 A. Ivey No. 6519

LCRC L.4, P.208

Found a 4" steel pipe with bronze cap stamped "State of Michigan" buried 0.4' below gravel in or near centerline of Bemis Road about 327' WSW of residence #3567.

10) P.P.	ENE	89.4' PK SE side
12) P.P.	WNW	137.7' PK S'ly side
13) Mich. Bell underground marker	SE	46.5'

5-24-1977 A. Ivey No. 6519

LCRC L.1595, P.503

Found a 4" steel pipe with bronze cap stamped "State of Michigan" buried 0.4' below gravel in or near centerline of Bemis Road about 327' WSW of residence #3567.

10) P.P.	ENE	89.4' PK SE side
12) P.P.	WNW	137.7' PK S'ly side
13) Mich. Bell underground marker	SE	46.5'

5-19-1977 N. Fahrner No. 17620

LCRC L.4, P.278

Iron pipe.

8) SW cor. house #3567	N76°E	326.47'
10) Telephone pole	N70°E	89.5'
11) Telephone pole	SOUTH	41.7'
12) P.P.	N70°W	138.1'

12-26-1978 R. Campbell No. 13028

LCRC L.5, P.126

Found 4" concrete monument with brass disc. Set 3/4" x 12" I.P. over 4" concrete mon. Set "Standard Road Box."

8) SW cor. house #3567	N80°E	326.5'
10) P.P.	N76°E	86.05'M PK SE side
12) P.P.	N70°W	137.88' PK SW side
14) Metal light pole	N72°E	179.6'
15) 2" Cherry	N38°E	70.6'
16) 2" Maple	N2°E	112.9'
17) 18" Maple	N52°W	189.45' nail NE side

3-13-1996 Atwell-Hicks, Inc.

Remonumentation

Found 3/4" I.P. in monument box with unreadable cap. Set aluminum remonumentation cap with PK nail in center over found pipe.

10) U.P.	N75°E	86.05' to nail & RT
12) U.P.	N70°W	138.06' to nail & RT
14) Metal Light Pole	N72°E	179.6' to center
18) Telephone riser	S55°E	46.5' to center