

MAY 09 1996

-copy-

COMMISSION LAND CORNER RECORDATION CERTIFICATE  
Filing Requirement of Act 74, Mich. P.A. 1970

For corners in

Washtenaw (County)	Located In:	Corner Code ##
1. Public Land Survey	T <u>3S</u> R <u>6E</u>	<u>L-13</u>
	T _____ R _____	_____
	T _____ R _____	_____
	T _____ R _____	_____
2. Property Controlling in Section	S _____ T _____ R _____	_____
	S _____ T _____ R _____	_____
3. Miscellaneous Property in Sec.	S _____ T _____ R _____	_____
	S _____ T _____ R _____	_____

REGISTER OF DEEDS  
COUNTY OF WASHTENAW  
MAY 29 1 11 PM '96  
RECORDED  
WASHTENAW COUNTY, MI  
Register of Deeds Stamp & File Number

- 4. Lot No. \_\_\_\_\_, Recorded Plat \_\_\_\_\_
- 5. Private Claims \_\_\_\_\_

I, Kenneth R. Coleman in a field survey on January 19, 1995, do hereby certify that under requirements of P.A. 74, Michigan P.A. of 1970, the corner points mentioned in lines 1 and 2 above were in conformance with regulations and rules therefore as required in the current manual of survey instructions of the United States Department of the Interior, Bureau of Land Management or by a decree of a Court of Law and/or that the corner points mentioned in lines 3, 4 and 5 above were in conformance with the rules of the Michigan Board of Land Surveyors or by a Decree of a Court of Law; established, re-established, monumented, re-monumented, recovered, found as expressed below:

NOTE: Not more than 4 corners, all in the same town and range, may be recorded on this certificate.

	A	B	C	D	E	F	G	H	I	J	K	L	M
2	6		5		4		3		2		1		
3													
4	7		8		9		10		11		12		
5													
6	16		17		16		15		14		13		
7													
8	19		20		21		22		23		24		
9													
10	30		29		28		27		26		25		
11													
12	31		32		33		34		35		36		
13													


A. Description of original monument and accessories and/or subsequent restoration:  
 1815 GLO GLO notes  
 Set post.  
 1) 15" W. Oak N50°E 27.06  
 2) 24" Do. N66°W 40.26

"A" continued on back

B. Description of corner evidence found and/or method applied in restoring or reestablishing corner:  
 1-19-1995 Atwell-Hicks, Inc. Remonumentation  
 Found 3/4" I.P. at gravel surface. Removed 3/4" X 18" I.P. Found 1 1/4" I.P. and brick fragmented 1.7' below gravel surface. Set 1" X 18" I.P. in 1 1/4" I.P. with remon. cap 0.4' below gravel surface.

C. Description of monument for corner and accessories established to perpetuate locating the position of the corner:  
 I find this corner to be the best available evidence of the position of the original corner.

"C" continued on back

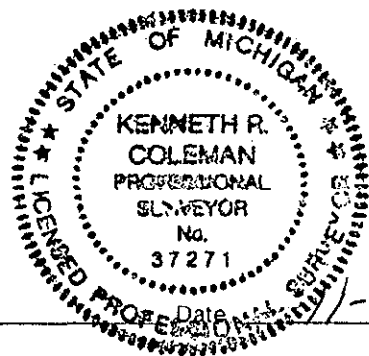

Signed by Kenneth R. Coleman Date May 21-1995  
 Surveyor's Michigan License No. 37271

- Copy -

"A" continued...  
 11-1887 C.S. Woodard Woodard's notes  
 Stake and stones  
 3) 18" W. Oak N71°W 85.1  
 4) 18" B. Oak N34½°W 39.6

7-17-1934 W.J. Armstrong Grid book  
 Found Woodard's wood stake, stones and some soft coal. Reset with a 1½" X 36"  
 iron pipe, stones and brick  
 4) 36" B. Oak N32°W 40.0  
 5) 20" B. Oak S62°E 48.6  
 6) 20" Tw. W. Oak S18°E 48.6  
 7) 36" B. Oak S20°W 110.5  
 8) 2" Hickory S60°W 40.0

2-14-55 Atwell-Hicks, Inc. Field book 619-35  
 Found corner 1.5' deep. Raised with ½" I.P.

10-26-72 John L. Snyder LCRC L.2, P.359  
 5) 20" B. Oak S62°E 48.3  
 6) 20" Tw. W. Oak S18°E 48.6  
 9) 18" B. Oak N17°W 60.9  
 10) 12" B. Oak N24°E 45.8  
 11) 20" B. Oak N76°E 86.7  
 12) 18" B. Oak S70°W 52.96

5-7-73 Washtenaw Engineering Co. Survey L.1452, P.81  
 Found ¾" I.P.  
 5) 33" B. Oak S62°E 48.3  
 6) 30" Tw. W. Oak S18°E 48.6  
 9) 20" W. Oak N30°W 61.02  
 12) 18" Hickory S50°W 53.03  
 13) Tele. pole N45°E 42.03

4-17-74 Midwestern Consulting, Inc. Survey  
 ¾" I.P.  
 5) 30" B. Oak S62°E 48.3  
 6) 30" Tw. W. Oak S18°E 48.6  
 9) 20" B. Oak N35°W 61.0  
 10) 14" W. Oak N20°E 45.6  
 12) 20" W. Oak S50°W 53.1

5-29-79 Roskelly Jekabson & Assoc. Survey L.1738, P.128  
 Found I.P.  
 9) 24" R. Oak N20°W 60.99 nail  
 12) 18" R. Oak S70°W 53.03 nail  
 13) Tele. pole N30°E 42.02 nail  
 14) Tele. pole S40°E 35.07 nail

2-17-80 Thomas Sutherland LCRC L.6, P.23  
 Found ¾" I.P.  
 5) 33" Oak S62°E 48.3  
 6) 30" Tw. Oak S18°E 48.6  
 9) 20" Oak N30°W 61.02  
 12) 18" Oak S60°W 53.08  
 13) Tele. pole N45°E 42.03

3-24-83 Midwestern Consulting Survey  
 ¾" I.P.  
 5) 30" B. Oak S62°E 48.3  
 6) 30" Tw. W.D. S18°E 48.6  
 9) 20" B. Oak N35°W 61.0  
 10) 14" W. Oak N20°E 45.6  
 12) 20" W. Oak N50°W 53.1

3-13-91 Midwestern Consulting Survey  
 9) 34" Oak N35°W 61.27  
 12) 28" Oak S60°W 52.59  
 13) U.P. N50°E 42.03  
 14) U.P. S45°E 35.14

1-19-1995 Atwell-Hicks, Inc. Remonumentation  
 Found ½" I.P. 0.5' below gravel surface. Dug down 1.2'. Found 1½" pipe with  
 bricks. Snapped off ½" pipe. Placed 1" X 9" I.P. over 1½" pipe with remon. cap  
 0.5' below gravel surface.  
 5) 26" Oak S62°E 47.82 C.L. tree  
 6) Twin 26" Oak S18°E 48.46 nail & R.T.  
 9) 22" Oak N17°W 60.58 nail & R.T.  
 10) 18" Oak N24°E 44.76 nail & R.T.  
 11) 28" Oak N76°E 86.86 C.L. tree  
 12) 22" Oak S70°W 53.16 nail & R.T.  
 13) P. pole N45°E 42.05 nail  
 14) P. pole S40°E 35.10 nail

APPROVED

DATE 4/24/95

C.S. REP. *K*