

SURVEY &
REMONUMENTATION

-copy-

MAY 09 1996

COMMISSION

LAND CORNER RECORDATION CERTIFICATE
Filing Requirement of Act 74, Mich. P.A. 1970

For corners in

Washtenaw
(County)

Located In: _____ Corner Code ## _____

1. Public Land Survey T 3S R 6E M-12
T _____ R _____
T _____ R _____
T _____ R _____

2. Property Controlling S _____ T _____ R _____
in Section S _____ T _____ R _____

3. Miscellaneous S _____ T _____ R _____
Property in Sec. S _____ T _____ R _____

4. Lot No. _____, Recorded Plat _____

5. Private Claims _____

REGISTERED
WASHTENAW COUNTY
MAR 29 1996
4:12 PM
PEOPLE'S REGISTER
COUNTY OF WASHTENAW
-copy-
Register of Deeds Stamp & File Number

	A	B	C	D	E	F	G	H	I	J	K	L
2	6	7	8	9	10	11	12	13	14	15	16	17
3												
4	7	8	9	10	11	12	13	14	15	16	17	18
5												
6	18	17	16	15	14	13	12	11	10	9	8	7
7												
8	19	20	21	22	23	24	25	26	27	28	29	30
9												
10	30	29	28	27	26	25	24	23	22	21	20	19
11												
12	31	32	33	34	35	36	37	38	39	40	41	42
13												

I, Kenneth R. Coleman in a field survey on January 19, 1995, do hereby certify that under requirements of P.A. 74, Michigan P.A. of 1970, the corner points mentioned in lines 1 and 2 above were in conformance with regulations and rules therefore as required in the current manual of survey instructions of the United States Department of the Interior, Bureau of Land Management or by a decree of a Court of Law and/or that the corner points mentioned in lines 3, 4 and 5 above were in conformance with the rules of the Michigan Board of Land Surveyors or by a Decree of a Court of Law; established, re-established, monumented, re-monumented, recovered, found as expressed below:

NOTE: Not more than 4 corners, all in the same town and range, may be recorded on this certificate.

A. Description of original monument and accessories and/or subsequent restoration:

1815 GLO GLO notes
Set post.
1) 15" B. Oak S65°E 14.52
2) 12" Do. S66°W 7.26


"A" continued on back

B. Description of corner evidence found and/or method applied in restoring or reestablishing corner:

1-19-1995 Atwell-Hicks, Inc. Remonumentation
Found 1/2" rod 0.5 below gravel surface. Removed 1/2" X 1" iron rod. No dip below. Replaced with 1" X 24" I.P. with remon. cap 0.5' below gravel surface.

C. Description of monument for corner and accessories established to perpetuate locating the position of the corner:
I find this corner to be the best available evidence of the position of the original corner.

"C" continued on back

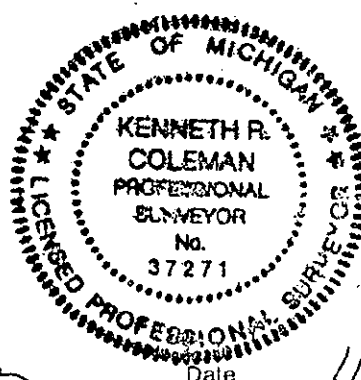

Signed by Kenneth R. Coleman Date 11-21-1995
Surveyor's Michigan License No. 37271

- Copy -

"A" continued...

11-1887 C.S. Woodard

Woodard's notes

Stake and stones.

3) 30" B. Oak	N4½°W	252.8
4) Ypsilanti corner	NORTH	200.6

9-24-37 W.J. Armstrong

Grid book

Found stake and stones as described by Woodward. Set iron pipe, stones and brick.

5) 26" Willow	N10°W	86.0
6) 12" Walnut	N3°W	155.2
7) 8" P.P.	S27°W	69.9

2-14-55 Atwell-Hicks, Inc.

Field book 619-35

4) A-11 Ypsilanti	NORTH	200.3
7) P.P.	S30°W	69.8
8) 1" I.P.	WEST	33.0
9) 4" Pine	S85°E	44.7

6-77 Control Survey Assoc.

Survey

6) 15" Walnut	N3°W	155.2
7) P.P.	S27°W	69.9

6-27-77 Midwestern Consulting, Inc.

Survey

9) 14" Pine	S80°E	45.88
10) Util. pole	S30°W	47.31
11) 14" Maple	S50°E	67.78
12) Int. of Munger & Merrit	NORTH	190'

2-17-80 Thomas Sutherland

Survey L.1784, P.130 & LCRC L.6, P. 23

Found ½" I.P.

7) P.P.	S27°W	67.82 nail
9) 18" Spruce	S80°E	44.39 nail
13) 8" Cherry	S45°W	47.05 nail
14) 14" Boxelder	S40°E	47.31 nail

"C" continued...

1-19-1995 Atwell-Hicks

Remon.

Found ½" I.P. 0.7' below gravel surface. Removed ½" X 18" I.P.
 Found 1½" I.P. 1.5' below gravel surface. Also found brick here.
 Placed ½" I.P. back into 1½" I.P. Placed a 1" X 24" I.P. over the
 ½" I.P. and pounded all such that the 1" I.P. is 0.5' below gravel
 surface. Set remon. cap.

7) U.P.	S27°W	67.78 nail & R.T.
8) 1" I.P.	W'ly	32.94
9) 18" Spruce	S80°E	44.92 nail & R.T.
14) 18" Boxelder	S40°E	47.32 nail & R.T.
15) 10" Cherry	S85°W	84.80 nail & R.T.
16) A-11 Ypsilanti Township	NORTH	200.48

APPROVED

DATE 4/24/95

CO. REP. Kx