

**SURVEY &  
REMONUMENTATION**

Liber **000001** Page **0497 RM**

MAY 09 1996

*Copy*

**COMMISSION**

**LAND CORNER RECORDATION CERTIFICATE  
Filing Requirement of Act 74, Mich. P.A. 1970**

For corners in

Washtenaw  
(County)

Located In:

Corner Code ##

- 1. Public Land Survey      T 3S R 6E  
                                   T 35 R 7E  
                                   T 4S R 6E  
                                   T 4S R 7E
- 2. Property Controlling    S \_\_\_\_\_ T \_\_\_\_\_ R \_\_\_\_\_  
    in Section                S \_\_\_\_\_ T \_\_\_\_\_ R \_\_\_\_\_
- 3. Miscellaneous            S \_\_\_\_\_ T \_\_\_\_\_ R \_\_\_\_\_  
    Property in Sec.         S \_\_\_\_\_ T \_\_\_\_\_ R \_\_\_\_\_

M-13  
A-19  
M-7  
A-1

RECORDED  
 WASHTEENAW COUNTY, MI  
 MAR 29 1 43 PM '96  
 COUNTY CLERK'S REGISTER  
 - COPY -

Register of Deeds Stamp & File Number

- 4. Lot No. \_\_\_\_\_, Recorded Plat \_\_\_\_\_
- 5. Private Claims \_\_\_\_\_

A	B	C	D	E	F	G	H	I	J	K	L	M
2	6	5	4	3	2	1						
3												
4	7	8	9	10	11	12						
5												
6	18	17	16	15	14	13						
7												
8	19	20	21	22	23	24						
9												
10	30	29	28	27	26	25						
11												
12	31	32	33	34	35	36						
13												

I, Kenneth R. Coleman in a field survey on January 19, 19 95, do hereby certify that under requirements of P.A. 74, Michigan P.A. of 1970, the corner points mentioned in lines 1 and 2 above were in conformance with regulations and rules therefore as required in the current manual of survey instructions of the United States Department of the Interior, Bureau of Land Management or by a decree of a Court of Law and/or that the corner points mentioned in lines 3, 4 and 5 above were in conformance with the rules of the Michigan Board of Land Surveyors or by a Decree of a Court of Law; established, re-established, monumented, re-monumented, recovered, found as expressed below:

**NOTE: Not more than 4 corners, all in the same town and range, may be recorded on this certificate.**

A. Description of original monument and accessories and/or subsequent restoration:

1815	GLO	GLO notes
Set post.		
1) 24" W. Oak	N61°E	25.74
2) 18" Do.	N35°W	14.52

"A" continued on back


B. Description of corner evidence found and/or method applied in restoring or reestablishing corner:

1-19-1995      Atwell-Hicks, Inc.      Remonumentation  
 Found 3/4" I.P. 0.6' below gravel surface. Dug to 1.2' and found the 3/4" pipe was in a 2" I.P. Placed remon. cap over 3/4" I.P. 0.6' below gravel surface.

C. Description of monument for corner and accessories established to perpetuate locating the position of the corner:

I find this corner to be the best available evidence of the position of the original corner.

"C" continued on back

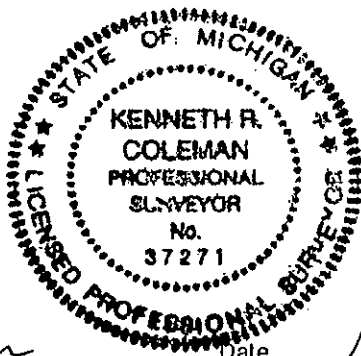

Signed by Kenneth R. Coleman  
 Surveyor's Michigan License No. 37271

Date 11-21-95/1995

*- Copy -*

"A" continued...

11-1887 C.S. Woodard  
Stake, tile brick & stone.

Woodard's notes

- |                |        |       |
|----------------|--------|-------|
| 3) 6" Hickory  | S74½°W | 69.0  |
| 4) 12" Hickory | S85°E  | 189.6 |

8-30-34 W.J. Armstrong

Grid book

Found Woodard's stake, tile and stone. Reset with a 2" X 40" iron pipe, stones and bricks.

- |                      |       |       |
|----------------------|-------|-------|
| 5) 7" Hickory        | N3½°E | 112.8 |
| 6) 7" Hickory        | N21°E | 69.6  |
| 7) 24" W. Oak        | S4½°W | 65.6  |
| 8) 10" Hickory       | S32°W | 16.9  |
| 9) 16" W. Oak        | N71°W | 81.7  |
| 10) 6" Hickory       | N57°W | 43.9  |
| 11) 6" Elm           | N25°W | 31.9  |
| 12) 6" Hickory       | N12°W | 60.1  |
| 13) 3 R. of W. pipes |       |       |

7-29-80 Wade-Trim

Fieldbook 980, P.61

Found 3/4" iron.

- |                |       |                |
|----------------|-------|----------------|
| 6) 12" Hickory | N18°E | 69.49 nail     |
| 9) 24" Oak     | N75°W | 82.07 PK nail  |
| 14) 12" Elm    | S9°W  | 27.53 nail     |
| 15) Hydrant    | S57°W | 51.61 top bolt |

"C" continued...

1-19-1995 Atwell-Hicks, Inc.

Remonumentation

Found 3/4" I.P. 0.6' below gravel surface. Dug to 1.2' and found the 3/4" pipe was in a 2" I.P. Placed remon. cap over 3/4" I.P. 0.6' below gravel surface.

- |                  |       |                   |
|------------------|-------|-------------------|
| 5) 14" Hickory   | N3½°E | 112.54 CL tree    |
| 6) 14" Hickory   | N21°E | 69.40 nail & R.T. |
| 7) 40" Oak       | S4½°W | 65.58 nail & R.T. |
| 9) 34" Oak       | N71°W | 80.84 nail & R.T. |
| 14) 12" twin Elm | S10°W | 27.62 nail & R.T. |
| 15) Hydrant      | S50°W | 51.62 nail & R.T. |

APPROVED

DATE 5/24/95  
CO. REP. FA