

MAY 2000

SECTION

LAND CORNER RECORDATION CERTIFICATE
Filing Requirement of Act 74, Mich. P.A. 1970

For corners in

WASHTENAW
(County)

Located In: YPSILANTI TOWNSHIP

Corner Code #

- 1. Public Land Survey T 3 S R 7 E
2. Property controlling in Section S T R
3. Miscellaneous Property in Sec. S T R

F-9




5094786
Page: 1 of 1
02/07/2000 02:55P
L-3 P-80

Peggy M. Haines - Washtenaw Co. CORREM

Register of Deeds Stamp & File Number

- 4. Lot No.
5. Private Claims

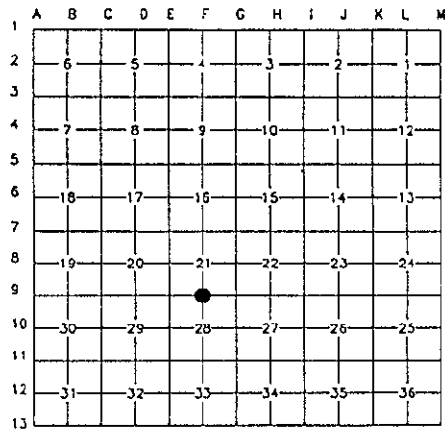

I, CHRISTOPHER S. LAMUS, in a field survey on DECEMBER 6, 19 99, do hereby certify that under requirements of P.A. 74, Michigan P.A. of 1970, the corner points mentioned in lines 1 and 2 above were in conformance with regulations and rules therefore as required in the current manual of survey instructions of the United States Department of the Interior, Bureau of Land Management or by decree of a Court of Law and/or that the corner points mentioned in lines 3,4 and 5 above were in conformance with the rules of the Michigan Board of Land Surveyors or by Decree of a Court of Law; established, reestablished, monumented, re-monumented, recovered, found as expressed below:

NOTE: Not more than 4 corners, all in the same town and range, may be recorded on this certificate

A. Description of original monument and accessories and/or subsequent restoration:

- ORIG. GOVERNMENT NOTES 1819
WITNESSED BY JOSEPH WAMPLER - SET POST
1) ELM 14" N73'E .23 CHAINS
2) ELM 9" S7'W .13 CHAINS
NO G.L.O. WITNESSES REMAIN
ATWELL-HICKS, INC. P.A. 132, L.1530, P.685 BY ROBERT J. JAGOW #6998 10/23/75
FOUND 1/2" I.P. @ SLY EDGE OF PAVEMENT
3) POPLAR 48" S45'W 66.9'
4) P.L. COR. NLY 59.85'
5) NLY END CONC. CULVERT 39.6'
P.A. 74 L.4, P.203 BY HOWARD W. TAFT #12032 5/16/77 FOUND 1/2" I. P.
6) 6" APPLE S30'W 28.1'
7) 4" CHINESE ELM S10'E 42.0'
8) 6" CHINESE ELM S30'E 46.9'
9) 12" POPULAR S65'E 41.0'
10) R.O.W. IRON S'LY NO DISTANE

- P.A. 74 L.8, P.155 BY THADDEUS A. WOZNAK #15066
12/20/94 FOUND IRON BAR IN ASPHALT
11) S50'E 61.98' SET "PK" NAIL N. SIDE 8" TREE
12) S70'W 29.89' SET "PK" NAIL N. SIDE 8" TREE
13) N45'E 64.85' SET "PK" NAIL S. SIDE 8" BOX ELDER
14) N55'W 93.70' FOUND NAIL S.W. SIDE POWER POLE
W.C.R.C. FIELD NOTES BY BOJ & JAG
AUGUST 18, 1997
FOUND 3/8" IRON REBAR
6) 10" APPLE S30'W 28.4'
7) 4" FD. DEAD CHINESE ELM S10'E 42.0'
8) 6" FD. DEAD CHINESE ELM S30'E 46.9'
12) 8" ELM S72'W 29.94' FD. PK & NAIL
14) U. POLE N46'W 94.00' FD. NAIL
15) 13" BOX ELDER N60'E 46.4'

- P.A. 74 L.8, P.280 BY JOHN A. REDASH #37281 7/14/97 FOUND 1/2" IRON SOUTH EDGE OF ASPHALT
13) N40'E 64.45' FD. PK NAIL NW FACE OF 12" MAPLE
14) N50'W 93.90' FD. PK NAIL SW FACE OF UTILITY POLE
16) S70'W 20.85' SET PK NAIL W/TAG RLS #17632, NW FACE OF 10" MAPLE
17) S30'E 62.00' FD. PK NAIL NE FACE OF 14"-12" MAPLE

SURVEY WORK SHEET FROM ATWELL-HICKS 1957: ANGLE AT F-9 FROM E-9 TO G-9: 169°54'00"(ALNM 1999) (169°55' A-H 1957); DISTANCE F-9 TO E-9 2614.92'(ALNM 1999) 2615.24'(A-H 1957); DISTANCE F-9 TO G-9 2744.13'(ALNM 1999) 2742.50'(A-H 1957)

B. Description of corner evidence and/or method applied in restoring or reestablishing corner:
F-9 YPSILANTI TOWNSHIP
FOUND 1/2" IRON PIPE 2" BELOW GRAVEL @ SOUTH EDGE OF PAVEMENT ON TEXTILE ROAD. DROVE 1" IRON PIPE OVER 1/2" IRON PIPE AND SET REMON CAP.

C. Description of monument for corner and accessories established to perpetuate locating the position of the corner:

- 1" IRON PIPE WITH ALUMINUM REMONUMENTATION CAP STAMPED #41914
6) S30'W 28.33' 7" APPLE SET REMON TAG
7) S10'E 41.99' FOUND DEAD 8" ELM
12) S72'W 29.94' SET REMON TAG OVER FOUND PK NAIL 8" ELM
13) N60'E 64.45' 13" BOX ELDER SET REMON TAG
14) N46'W 93.93' U.P. SET REMON TAG OVER FD. NAIL



I CONCLUDE AFTER CAREFUL STUDY OF THE RECORD DOCUMENTATION AND FIELD OBSERVATIONS, THAT THIS CORNER IS ACCEPTED AS THE BEST AVAILABLE EVIDENCE OF THE POSITION OF THE ORIGINAL CORNER. THIS POINT WAS RATIFIED BY THE WASHTENAW COUNTY PEER COMMITTEE ON DECEMBER 20, 1999.

Signed by [Signature]
Surveyor's Michigan License No. 41914

Date 12/21/99
APPROVED
DATE 12/13/99
CO. REP. [Signature]