

MAY 2000

SECTION

LAND CORNER RECORDATION CERTIFICATE
Filing Requirement of Act 74, Mich. P.A. 1970

For corners in
WASHTENAW
(County)

Located In: YPSILANTI TOWNSHIP

Corner Code #

- 1. Public Land Survey T 3 S R 7 E
2. Property controlling in Section S T R
3. Miscellaneous Property in Sec. S T R
4. Lot No. , Recorded Plat
5. Private Claims

F-11




5094787
Page: 1 of 1
02/07/2000 02:55P

Peggy M. Haines - Washtenaw Co. CORREM

Register of Deeds Stamp & File Number

I, CHRISTOPHER S. LAMUS, in a field survey on DECEMBER 4, 19 99, do hereby certify that under requirements of P.A. 74, Michigan P.A. of 1970, the corner points mentioned in lines 1 and 2 above were in conformance with regulations and rules therefore as required in the current manual of survey instructions of the United States Department of the Interior, Bureau of Land Management or by decree of a Court of Law and/or that the corner points mentioned in lines 3, 4 and 5 above were in conformance with the rules of the Michigan Board of Land Surveyors or by Decree of a Court of Law; established, reestablished, monumented, re-monumented, recovered, found as expressed below:

NOTE: Not more than 4 corners, all in the same town and range, may be recorded on this certificate

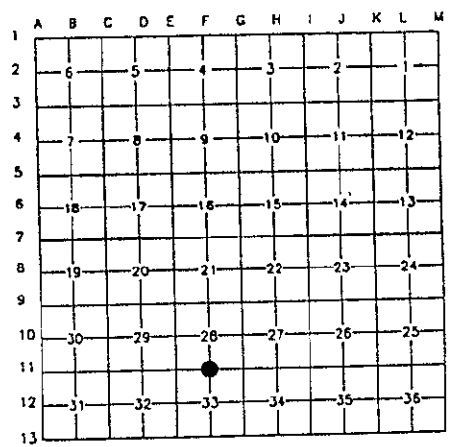

A. Description of original monument and accessories and/or subsequent restoration:

ORIG. GOVERNMENT NOTES 1819
DID NOT SET DUE TO SWAMP & THICKET
G.L.O. S. PETTIBONE SET WOOD STAKE & STONE
1) ELM 24" N40 1/2"E .97 CHAINS
2) W. OAK 36" S52 1/2"E .5 CHAINS
NO G.L.O. WITNESSES REMAIN

ATWELL-HICKS P.A. 132, L.1397, P.515
BY HOWARD TAFT #12032 5/22/72
FOUND 1 1/2" IRON PIPE
5) EDSION POLE S28"W 76.4'
7) 3 1/2" GAS PIPE MARKER N10"E 24.1'
8) 3 1/2" GAS PIPE MARKER S50"E 54.5'
9) 3/4" R/W IRON PIPE NORTH 33.00'
10) 6" & 4" TWIN HICKORY S60"E 102.0'

WASHTENAW ENGINEERING P.A. 132, L.2021, P.439 BY THOMAS L. SUTHERLAND #24620 1/2/85
FOUND 1/2" IRON PIPE
5) NAIL IN P. POLE S30"W 76.66'
8) GAS PIPELINE MARKER S50"E 54.42'
12) NAIL IN 3" ELM N60"W 75.50'
13) SW COR. OF FOUNDATION N25"E 130.59'

W.C.R.C. FIELD NOTES TRANSCRIBED FROM
W.J. ARMSTRONG NOTES 4/48/37
FOUND STREAK OF OLD WOOD STAKE IN CENTER OF STONE RESET 1 1/2"x36" IRON PIPE IN STONES & BRICK.
3) S.W. CORNER OF BRIDGE FLOOR N89'E 218.4'
4) TRIPLE 3" ELM S75"E 90.7'
5) EDISON POLE S28"W 75.4' (POSSIBLE TYPO 76.4')
6) 12" HICKORY S81"W 237.6'

P.A. 132, L.1421, P.792 & P.A. 74 L.2, P.395 BY RALPH J. LANDINI #16933 6/13/72 FOUND IRON PIPE
5) UTILITY POLE S28"W 76.30'
7) MICHCON GAS MARKER N16"E 24.09'
9) R/W IRON PIPE NORTH 33.00'
11) 8" OAK S75"E 101.26'
APEX SURVEY CO. P.A. 132, L.1521, P.426 BY JOHN J. EMIG #10059 3/25/74
FOUND 1 1/2" IRON PIPE
7) .30' GAS MARKER NE'LY 24.09'
8) .30' GAS MARKER SE'LY 54.46'

P.A. 74 L.7, P.320 BY EUGENE ZEIMET 1992 RESET CAPPED IRON
5) UTILITY POLE S30"W 76.38'
8) GAS MARKER N50"E (TYPO S50"E) 54.60'
9) R/W IRON PIPE N5"E 33.56'
14) TOP NUT OF HYDRANT N15"W 26.85'
W.C.R.C. FIELD NOTES BY BOJ & JAG 8/8/95 FOUND P.K. @ ROAD SURFACE
5) UTILITY POLE S28"W 76.29'
14) TOP NUT OF HYDRANT N15"W 26.88'
15) SET NAIL IN U. POLE S20"E 71.66'
16) 3/8" REROD CONC. MON. SOUTH 59.96'

B. Description of corner evidence and/or method applied in restoring or reestablishing corner:

F-11 NORTH 1/4 SECTION 33 YPSILANTI TOWNSHIP
FOUND P.K. NAIL IN ASPHALT AT CL MERRITT ROAD AND 64.5' EAST OF CL STREAMWOOD DRIVE. OFFSET PK. CORED AND DUG 1.0'. NO READINGS. SET MONUMENT BOX AND SET 3/4" IRON PIPE AND REMON CAP IN BOX.

C. Description of monument for corner and accessories established to perpetuate locating the position of the corner:

- F-11
SET MON. BOX AND 3/4" IRON PIPE WITH ALUMINUM CAP STAMPED #41914
5a) FOUND BENT" 50d NAIL SE SIDE OF P. POLE S30"W 76.41'
5b) SET REMON TAG OVER FOUND P.K. NAIL IN EAST SIDE P. POLE S30"W 76.26'
5c) FOUND P.K. NAIL & RIBBON NW SIDE OF P. POLE S30"W 76.39'
14) TOP NUT OF HYDRANT N15"W 26.80'
15) SET REMON TAG OVER FOUND 40d NAIL IN EAST SIDE P. POLE S20"E 71.62'
17) TOP NUT OF HYDRANT S23"W 75.51'
18) SET MAG NAIL & REMON DISC IN SE SIDE OF 6" PINE N68"E 112.41'
19) SET MAG NAIL & REMON DISC IN NW SIDE OF P. POLE S70"W 180.42'

I CONCLUDE AFTER CAREFUL STUDY OF THE RECORD DOCUMENTATION AND FIELD OBSERVATIONS, THAT THIS CORNER IS ACCEPTED AS THE BEST AVAILABLE EVIDENCE OF THE POSITION OF THE ORIGINAL CORNER. THIS POINT WAS RATIFIED BY THE WASHTENAW COUNTY PEER COMMITTEE ON DECEMBER 20, 1999.

Signed by [Signature]
Surveyor's Michigan License No. 41914



12/21/99

APPROVED
DATE 12/13/99
CO. REP. KA