

REM

JAN 2000

SECTION

LAND CORNER RECORDATION CERTIFICATE
Filing Requirement of Act 74, Mich. P.A. 1970

For corners in:

WASHTENAW
(County)

Located In: YPSILANTI TOWNSHIP

Corner Code #

- 1. Public Land Survey T 3 S R 7 E
2. Property controlling in Section S T R
3. Miscellaneous Property in Sec. S T R

G-9




5094789
Page: 1 of 1
02/07/2000 02:56P

Peggy M. Haines - Washtenaw Co. CORREM L-3 P-83

Register of Deeds Stamp & File Number

- 4. Lot No. , Recorded Plot
5. Private Claims

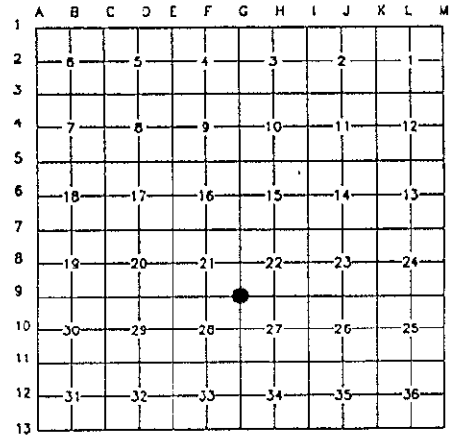

I, CHRISTOPHER S. LAMUS, in a field survey on DECEMBER 4, 19 99, do hereby certify that under requirements of P.A. 74, Michigan P.A. of 1970, the corner points mentioned in lines 1 and 2 above were in conformance with regulations and rules therefore as required in the current manual of survey instructions of the United States Department of the Interior, Bureau of Land Management or by decree of a Court of Law and/or that the corner points mentioned in lines 3,4 and 5 above were in conformance with the rules of the Michigan Board of Land Surveyors or by Decree of a Court of Law; established, reestablished, monumented, re-monumented, recovered, found as expressed below:

NOTE: Not more than 4 corners, all in the same town and range, may be recorded on this certificate

A. Description of original monument and accessories and/or subsequent restoration:

ORIG. GOVERNMENT NOTES 1819
WITNESSED BY JOSEPH WAMPLER - SET POST
1) LYNN 22" S64°W 24 LINKS
2) BEECH 23" N46°E 25 LINKS
NO G.L.O. WITNESSES REMAIN

W.C.R.C. FIELD NOTES TRANSCRIBED FOR W.J. ARMSTRONG 8/2/34 WITNESSES TO 1 1/2" IRON PIPE.

- 3) 3" RED OAK S65°W 83.5'
4) 7" RED OAK S71°W 128.4'
5) 14" ELM N84°E 78.2'
6) 8" PEAR N40°W 75.3'
7) 6" PEAR S17°E 58.3'

- P.A. 74 L.7, P.324 BY THADDEUS WOZNIAK 11/7/92 FOUND IRON BAR IN SHOULDER OF ROAD
8) FOUND NAIL IN EAST SIDE OF 15" PINE S20°W 56.35'
9) SET PK NE SIDE OF 6" TREE S30°E 53.30'
10) CENTER OF SANITARY MANHOLE COVER N75°W 38.49'
11) FOUND CHISELED 'X' WEST SIDE OF SANITARY MANHOLE COVER N70°E 69.97'

- W.C.R.C. FIELD NOTES BY BOJ & JAG 8/18/97 FOUND 3/8" IRON REBAR
8) FOUND NAIL IN EAST SIDE OF 15" PINE S20°W 56.35'
9) SET PK NE SIDE OF 6" TREE S30°E 53.30'
10) CENTER OF SANITARY MANHOLE COVER N75°W 38.5'
11) FOUND CHISELED 'X' WEST SIDE OF SANITARY MANHOLE COVER N70°E 69.97'

B. Description of corner evidence and/or method applied in restoring or reestablishing corner:

G-9 YPSILANTI TOWNSHIP

FOUND 1/2" IRON BAR 9" BELOW GRAVEL 1.1'+/- OFF NORTH SIDE EDGE OF PAVEMENT OF TEXTILE ROAD. DUG FURTHER AND FOUND 3/4" IRON PIPE INSIDE A 1 1/2" IRON PIPE SURROUNDED BY BROKEN TILE. DROVE 1" IRON PIPE OVER 1 1/2" PIPE THEN SET REMON CAP.

C. Description of monument for corner and accessories established to perpetuate locating the position of the corner:

SET 1" IRON PIPE WITH ALUMINUM REMONUMENTATION CAP STAMPED #41914 ABOVE THE 1 1/2" IRON PIPE.

- 8) SET REMON TAG OVER FOUND NAIL & RIBBON IN 15" PINE S20°W 56.38'
10) CENTER OF SANITARY MANHOLE COVER N75°W 38.55'
11) FOUND CHISELED 'X' WEST SIDE OF SANITARY MANHOLE COVER N70°E 69.92'
12) SET REMON TAG OVER FOUND MAG NIL EAST SIDE OF TWIN 9" ASH S10°E 46.06'
13) SET REMON TAG OVER FOUND NAIL & PLASTIC TAG NORTH SIDE OF 10" OAK S60°E 67.20'
14) SET REMON TAG IN EAST SIDE OF 28" POPLAR N10°E 77.68'

I CONCLUDE AFTER CAREFUL STUDY OF THE RECORD DOCUMENTATION AND FIELD OBSERVATIONS, THAT THIS CORNER IS ACCEPTED AS THE BEST AVAILABLE EVIDENCE OF THE POSITION OF THE ORIGINAL CORNER. THIS POINT WAS RATIFIED BY THE WASHTENAW COUNTY PEER COMMITTEE ON DECEMBER 20, 1999.

Signed by Christopher S. Lamus
Surveyor's Michigan License No. 41914



Date 12/21/99

APPROVED
DATE 12/20/99
CO. REP. K