

REN
2000

SECTION

LAND CORNER RECORDATION CERTIFICATE
Filing Requirement of Act 74, Mich. P.A. 1970

For corners in
WASHTENAW
(County)

Located In: YPSILANTI
TOWNSHIP

Corner Code #

- 1. Public Land Survey T 3 S R 7 E
- 2. Property controlling in Section S _____ T _____ R _____
- 3. Miscellaneous Property in Sec. S _____ T _____ R _____
- 4. Lot No. _____, Recorded Plot _____
- 5. Private Claims _____


G-10



5094790
Page: 1 of 1
02/07/2000 02:55P

Peggy M. Haines - Washtenaw Co. CORREM L-3 P-84

Register of Deeds Stamp & File Number

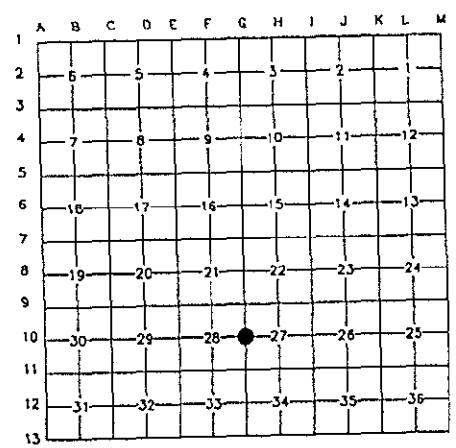

I, CHRISTOPHER S. LAMUS, in a field survey on DECEMBER 6, 19 99, do hereby certify that under requirements of P.A. 74, Michigan P.A. of 1970, the corner points mentioned in lines 1 and 2 above were in conformance with regulations and rules therefore as required in the current manual of survey instructions of the United States Department of the Interior, Bureau of Land Management or by decree of a Court of Law and/or that the corner points mentioned in lines 3, 4 and 5 above were in conformance with the rules of the Michigan Board of Land Surveyors or by Decree of a Court of Law; established, reestablished, monumented, re-monumented, recovered, found as expressed below:

NOTE: Not more than 4 corners, all in the same town and range, may be recorded on this certificate

A. Description of original monument and accessories and/or subsequent restoration:

ORIG. GOVERNMENT NOTES 1819
WITNESSED BY JOSEPH WAMPLER - SET POST
1) HICKORY 24" S8°W 7 LINKS
2) ASH 9" N34°W 18 LINKS
NO G.L.O. WITNESSES REMAIN

P.A. 74 L.B. P.155 BY THADDEUS
WOZNIAK #15066 12/20/94 FOUND IRON BAR IN SHOULDER OF
ROAD
3) SET NAIL IN SOUTH SIDE OF 24" OAK EAST 12.08'
4) SET NAIL IN SOUTH SIDE OF 8" OAK WEST 15.16'
5) SET NAIL IN NORTHWEST SIDE OF 3" TREE S30°W 11.88'
6) EAST FACE OF LARGE ROCK N80°W 3.56'

SURVEY WORK SHEET FROM ATWELL-HICKS 1957
ANGLE AT G-10 FROM G-9 TO G-11
179°56'28"(ALNM 1999) 179°55'19"(A-H 1957)
DISTANCE G-10 TO G-9
2649.86'(ALNM 1999) 2648.54' (A-H 1957)
DISTNACE G-10 TO G-11
2641.83'(ALNM 1999) 2642.06'(A-H 1957)

B. Description of corner evidence and/or method applied in restoring or reestablishing corner:

G-10 YPSILANTI TOWNSHIP
FOUND CONCRETE MONUMENT 0.41 FEET NORTH OF FENCE ANGLE POINT. SET REMON WASHER WITH SURVEYOR'S CAP #41914 ON MONUMENT.

C. Description of monument for corner and accessories established to perpetuate locating the position of the corner:

- CONCRETE MONUMENT WITH SURVEYOR'S CAP #41914
- 3) SET REMON TAG OVER FOUND NAIL IN SOUTH SIDE OF 24" OAK EAST 12.06'
- 4) SET REMON TAG OVER FOUND NAIL IN SOUTH SIDE OF 8" OAK WEST 15.14'
- 6) NORTHEAST CORNER OF LARGE ROCK N80°W 3.56'
- 7) FOUND IRON REBAR LOTS 206 & 207 WEST 82.21'
- 8) FOUND IRON REBAR LOTS 207 & 208 S88°E 8.93'
- 9) SET MAG NAIL WITH REMON WASHER NORTHEAST SIDE OF 4" OAK N80°W 7.41'
- 10) SET MAG NAIL WITH REMON WASHER WEST SIDE OF 5" JUNIPER N10°E 22.5'



I FIND NO EVIDENCE TO CONFLICT WITH THE ACCEPTANCE OF THIS POINT AS BEING THE BEST AVAILABLE EVIDENCE FOR THE POSITION OF THIS CORNER. THIS POINT WAS RATIFIED BY THE WASHTENAW COUNTY PEER COMMITTEE ON DECEMBER 20, 1999.

Signed by Christopher S. Lamus
Surveyor's Michigan License No. 41914

Date 12/21/99

APPROVED
DATE 12/20/99
CO. REP. KJ