

REM

MAY 20 2000

SECTION

LAND CORNER RECORDATION CERTIFICATE
Filing Requirement of Act 74, Mich. P.A. 1970

For corners in

WASHTENAW
(County)

Located in: YPSILANTI TOWNSHIP

Corner Code #

H-11

Copy

- 1. Public Land Survey T 3 S R 7 E
2. Property controlling in Section S T R
3. Miscellaneous Property in Sec. S T R




5094795
Page: 1 of 1
02/07/2000 02:55P

Peggy M. Haines - Washtenaw Co. CORREM L-3 P-89

Register of Deeds Stamp & File Number

- 4. Lot No. , Recorded Plat
5. Private Claims

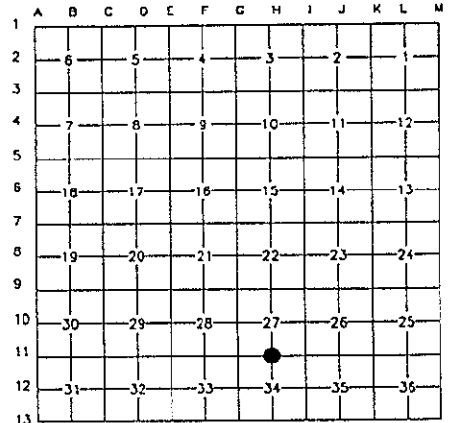

I, CHRISTOPHER S. LAMUS, in a field survey on DECEMBER 4, 19 99, do hereby certify that under requirements of P.A. 74, Michigan P.A. of 1970, the corner points mentioned in lines 1 and 2 above were in conformance with regulations and rules therefore as required in the current manual of survey instructions of the United States Department of the Interior, Bureau of Land Management or by decree of a Court of Law and/or that the corner points mentioned in lines 3,4 and 5 above were in conformance with the rules of the Michigan Board of Land Surveyors or by Decree of a Court of Law; established, reestablished, monumented, re-monumented, recovered, found as expressed below:

NOTE: Not more than 4 corners, all in the same town and range, may be recorded on this certificate

A. Description of original monument and accessories and/or subsequent restoration:

ORIG. GOVERNMENT NOTES 1819
WITNESSED BY JOSEPH WAMPLER - SET POST
1) ASH 11" S03E 18 LINKS
2) ELM 30" S89W 13 LINKS
NO G.L.O. WITNESSES REMAIN
P.A. 74 L.4, P.160 BY JOHN L. SNYDER
#13352 9/16/76
SET IRON PIPE FOR SOUTH 1/4 CORNER AT THE INTERSECTION OF THE CENTERLINE OF MERRITT ROAD AND A LINE BETWEEN THE CENTER OF SECTION AND A POINT ON LINE MIDWAY BETWEEN THE SOUTHEAST AND SOUTHWEST SECTION CORNERS
1/2" IRON PIPE
3) NORTH END BRIDGE RETAIN WALL N45W 17.25'
4) SOUTH END BRIDGE RETAIN WALL S45W 15.45'
5) 18" ASH N55W 30.0'
6) 12" ASH NORTH 46.6'
7) 14" IRONWOOD S35E 43.4'

FIELD NOTES FROM A-H G. BRENDERS & P. SELLERS 10/13/89 JOB# 38612
FOUND 1" IRON PIPE
8) 12" ELM N15W 37.9'
9) 16" ASH NORTH 41.6'
10) N. END OF 60" CULVERT N5W 19.4'
11) S. END OF 60" CULVERT S5W 31.4'

FIELD NOTES FROM A-H 3/22/95 JOB# 41659
FOUND 3/4" IRON PIPE
8) 16" ELM N15W 37.95'
9) 16" ASH NORTH 41.65'
10) N. END OF 60" CULVERT NORTH 19.35'
11) S. END OF 60" CULVERT S20W 31.17'

B. Description of corner evidence and/or method applied in restoring or reestablishing corner:

H-11 NORTH 1/4 CORNER OF SECTION 34 OF YPSILANTI TOWNSHIP
FOUND 1" IRON PIPE 8.5' NORTH FROM CL MERRITT ROAD AND 4.5' EAST OF THE CL OF CULVERT. THIS IRON IS NOT IN THE SAME LOCATION AS THE 1/2" IRON PIPE SET BY SNYDER. FURTHER RESEARCH INDICATES THAT THE 1" IRON PIPE FOUND IS INCORRECT. BASED ON FIELD NOTES FOR SNYDER'S SURVEY THE CORNER SHOULD BE 5.09' SOUTH AND 0.21' WEST OF THE FOUND IRON PIPE. SET 1" IRON PIPE AND REMON CAP AT THIS POSITION.

C. Description of monument for corner and accessories established to perpetuate locating the position of the corner:

- SET 1" IRON PIPE WITH ALUMINUM REMONUMENTATION CAP STAMPED #41914
6) SET REMON TAG OVER FOUND 20d NAIL IN WEST SIDE OF OF 16" ASH N02W 46.59'
8) SET REMON TAG OVER FOUND 40d NAIL NORTHEAST SIDE OF 20" ELM N30W 42.06'
10) NOTCH AT APPROX. CL OF NORTH END OF 84" CMP N14W 24.27'
11) NOTCH AT APPROX. CL OF SOUTH END OF 84" CMP S05W 26.11'
12) FOUND 1" IRON PIPE #27446 SOUTH 27.99'
13) SET REMON TAG OVER FOUND MAG NAIL & RIBBON IN CL OF EAST END SOUTH RETAIN. WALL S07E 26.17'
14) SET REMON TAG OVER FOUND NAIL & RIBBON SOUTH SIDE OF 24" SYCAMORE N85E 122.01'
15) FOUND 1" IRON PIPE NORTH 33.00'
16) FOUND 1" IRON PIPE NORTH 5.09' (DETERMINED TO BE AN INCORRECT CORNER)

AFTER CAREFUL EXAMINATION OF RECORD DOCUMENTATION AND FIELD OBSERVATIONS, I BELIEVE THIS POINT SHOULD BE ACCEPTED AS THE BEST AVAILABLE EVIDENCE OF THE POSITION OF THE ORIGINAL CORNER. THIS POINT WAS RATIFIED BY THE WASHTENAW COUNTY PEER COMMITTEE ON DECEMBER 20, 1999.

Signed by Christopher S. Lamus
Surveyor's Michigan License No. 41914



12/21/99

APPROVED
DATE 12/20/99
CO. REP. KA