

APPROVED

DATE 11-20-96

CO. REP. K

LAND CORNER RECORDATION CERTIFICATE

Filing Requirement of Act 74, Mich. P.A. 1970

RECORDED
WASHTENAW COUNTY, MI
FEB 20 9 14 AM '97
COUNTY CLERK/REGISTRAR

For corners in

Washtenaw

County

Located in:

Ypsilanti

Corner Code

I-12

1. Public Land Survey		T 3 S R 7 E	
		T	
		T	
		T	
2. Property Controlling in Section	S	T	
	S	T	
3. Miscellaneous Property in Sec.	S	T	
	S	T	

Liber 00001 Page 0632R

Register of Deeds Stamp and File Number

- 4. Lot No. _____, Recorded Plat _____
- 5. Private Claims _____

A	B	C	D	E	F	G	H	I	J	K	L	M
2	6	5	4	3	2	1						
3												
4	7	8	9	10	11	12						
5												
6	18	17	16	15	14	13						
7												
8	19	20	21	22	23	24						
9												
10	30	29	28	27	26	25						
11												
12	31	32	33	34	35	36						
13												

I, Michael S. Hoben in a field survey on 03/03/1996
do hereby certify that under requirements of P.A. 74, Michigan P.A. of 1970, the corner points mentioned in lines 1 and 2 above were in conformance with regulations and rules therefore as required in the current manual of survey instructions of the United States Department of the Interior, Bureau of Land Management. or by a decree of a Court of Law and/or that the corner points mentioned in lines 3, 4 and 5 above were in conformance with the rules of the Michigan Board of Land Surveyors or by a Decree of a Court of Law, established, re-established, monumented, re-monumented, recovered, found as expressed below.

NOTE: Not more than 4 corners, all in the same town and range, may be recorded on this certificate.

A. Description of original monument and accessories and/or subsequent restorations:
03/03/1816 G.L.O. SET POST
7" LYNN S17W 26 LINKS
16" LYNN N35E 14 LINKS

(Witnesses Continued on Back ...)

B. Description of corner evidence found and/or method applied in restoring or reestablishing corner:
FD. 1" I.P., REMOVED AND FD. 1 1/2" I.P. RESET 1" I.P. OVER 1 1/2" I.P.

C. Description of monument for corner and accessories established to perpetuate locating the position of the corner:
03/03/1996 HOBEN 35994 ORCHARD, REMON
HILTZ & MCCLIMENT
SET MON BOX AND W.C.R.CAP OVER 1" FD. IRON PIPE.

- 2 FD. OLD NAIL IN S. SIDE 36" TREE N60W 100.55'
- 6 FD. TAG #1761 IN E. SIDE 42" TREE N20W 73.40'
- 7 FD. TAG # 1761 IN E. SIDE DE POLE S40W 42.38'
- 8 FD. TAG #1761 IN S. SIDE 24" TREE N50W 68.80'

SURVEY & MONUMENTATION

MAY 05 1997

We conclude that after careful study of the record documentation and field observations, that this corner is accepted as the best available evidence of the position of the original corner.


Signed by Michael S. Hoben Date 11-26-96

Drafted by Michael S. Hoben

Surveyor's Michigan License No. 35994

Orchard, Hiltz and McCliment, Inc. 34935 Schoolcraft Road Livonia, MI 48150

COPY

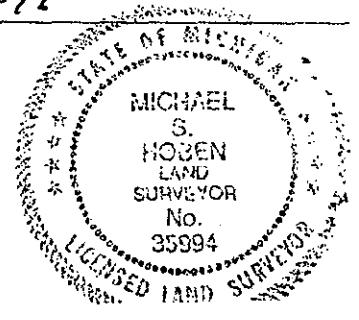

(Continued) Description of original monument and accessories and/or subsequent restorations:

11/16/1938 Armstrong 1244 W.C.R.C.

Fd. stone reset with 1/12" X 36" with bricks and stones around it.

- 1 CLUMP OF MAPLES N 38 E 39.80'
- 2 24" MAPLE N 72 W 100.80'
- 3 22" MAPLE N 71 W 60.60'
- 4 SPRUCE 20" N 50 W 106.10'
- 5 22" SPRUCE N 33 W 97.70'
- 6 30" MAPLE N 22 W 73.30'

06/28/1983 Campbell
SAME AS ABOVE

L. 6, P