

APPROVED
 DATE 11-20-96
 CO. REP. KA

LAND CORNER RECORDATION CERTIFICATE
 Filing Requirement of Act 74, Mich. P.A. 1970

RECORDED
 WASHTEENAW COUNTY, MI
 FEB 18 9 24 AM '97
 PEGGY M. HAINES
 COUNTY CLERK/REGISTER

For corners in
Washtenaw
 County

Located in:
Ypsilanti

Corner Code
I-13

1. Public Land Survey	T	3	S	R	7	E	
	T			R			
	T			R			
	T			R			
	T			R			
2. Property Controlling in Section	S			T			
	S			T			
3. Miscellaneous Property in Sec.	S			T			
	S			T			

4. Lot No. _____, Recorded Plat _____
 5. Private Claims _____

Liber 000001 Page 0630 Rm

Register of Deeds Stamp and File Number

I, Michael S. Hoben in a field survey on 02/23/1996
 do hereby certify that under requirements of P.A. 74, Michigan P.A. of 1970, the corner points mentioned in lines 1 and 2 above were in conformance with regulations and rules therefore as required in the current manual of survey instructions of the United States Department of the Interior, Bureau of Land Management, or by a decree of a Court of Law and/or that the corner points mentioned in lines 3, 4 and 5 above were in conformance with the rules of the Michigan Board of Land Surveyors or by a Decree of a Court of Law, established, re-established, monumented, re-monumented, recovered, found as expressed below.

NOTE: Not more than 4 corners, all in the same town and range, may be recorded on this certificate.

	A	B	C	D	E	F	G	H	I	J	K	L	M
2	6	5	4	3	2	1							
3													
4	7	8	9	10	11	12							
5													
6	18	17	16	15	14	13							
7													
8	19	20	21	22	23	24							
9													
10	30	29	28	27	26	25							
11													
12	31	32	33	34	35	36							
13													

A. Description of original monument and accessories and/or subsequent restorations:

03/03/1816 G.L.O. SET POST
 12" ASH N85E 23 LINKS
 12" ASH S75W 21 LINKS

(Witnesses Continued on Back ...)

B. Description of corner evidence found and/or method applied in restoring or reestablishing corner:

Fd. 1 1/2" i.p. w/ red brick 1.80' below surface of gravel rd.

C. Description of monument for corner and accessories established to perpetuate locating the position of the corner:


02/23/1996 Hoben 35994 O.H.M. Remon
 SET REMON CAP OVER 1 1/2" I.P.
 4 SET WCRC TAG IN S SIDE DE POLE N 85 E 195.03'
 5 SET WCRC IN N SIDE FENCE POST S 50 E 49.10'
 6 SET WCRC TAG IN S SIDE DE POLE N 85 W 158.90'
 7 SET WCRC TAG IN N SIDE MBT POLE 168.60'
 8 Fd. IRON W 230.25'

SURVEY &
 REMONUMENTATION
 MAY 05 1997
 COMMISSION

We conclude that after careful study of the record documentation and field observations, that this corner is accepted as a careful and faithful perpetuation of the position of the original corner.

Signed by Michael S. Hoben Date 11-26-96
 Drafted by Michael S. Hoben
 Surveyor's Michigan License No. 35994
 Orchard, Hiltz and McCliment, Inc. 34935 Schoolcraft Road Livonia, MI 48150

COPY

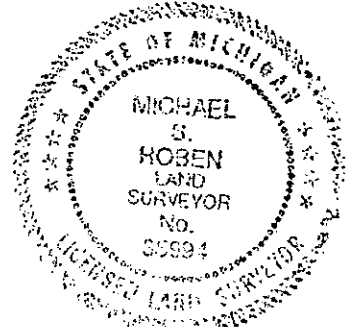

A. (Continued) Description of original monument and accessories and/or subsequent restorations:

09/18/1934 Lowe W.C.R.C. NO RECORD

1 12" APPLE N 3 E 66.7'

2 14" APPLE S 72 E 89.0'

3 14" APPLE S 62 W 53.4'

10/10/1934 Armstrong

Fd. stones and old wood stake &
set 1 1/2" i.p. w/stones around it.

SAME AS ABOVE

77002