

APPROVED

DATE 11-20-96

CO. REP. KA

LAND CORNER RECORDATION CERTIFICATE

Filing Requirement of Act 74, Mich. P.A. 1970

RECORDED  
 WASHTEENAW COUNTY, MI  
 FEB 28 9 15 AM '97  
 TERRY M. HAINES  
 COUNTY CLERK/REGISTER

For corners in

Washtenaw

County

Located in:

Ypsilanti

Corner Code

1. Public Land Survey		T 3 S R 7 E	J-13
		T	
		T	
		T	
		T	
2. Property Controlling in Section	S	T	
	S	T	
3. Miscellaneous Property in Sec.	S	T	
	S	T	

Register of Deeds Stamp and File Number

4. Lot No. \_\_\_\_\_, Recorded Plat \_\_\_\_\_  
 5. Private Claims \_\_\_\_\_

	A	B	C	D	E	F	G	H	I	J	K	L	M
2	6		5		4		3		2		1		
3													
4	7		8		9		10		11		12		
5													
6	18		17		16		15		14		13		
7													
8	19		20		21		22		23		24		
9													
10	30		29		28		27		26		25		
11													
12	31		32		33		34		35		36		
13													

I, Michael S. Hoben in a field survey on 02/23/1996  
do hereby certify that under requirements of P.A. 74, Michigan P.A. of 1970, the corner points mentioned in lines 1 and 2 above were in conformance with regulations and rules therefore as required in the current manual of survey instructions of the United States Department of the Interior, Bureau of Land Management. or by a decree of a Court of Law and/or that the corner points mentioned in lines 3, 4 and 5 above were in conformance with the rules of the Michigan Board of Land Surveyors or by a Decree of a Court of Law, established, re-established, monumented, re-monumented, recovered, found as expressed below.

NOTE: Not more than 4 corners, all in the same town and range, may be recorded on this certificate.

A. Description of original monument and accessories and/or subsequent restorations:

03/03/1816 G.L.O. SET POST  
 24" ELM N30W 7 LINKS  
 12" ASH WEST 7 LINKS

(Witnesses Continued on Back ...)

B. Description of corner evidence found and/or method applied in restoring or reestablishing corner:

FD. 1 1/2" I.P. 7' S. OF CL BEMIS IN GRAVEL

C. Description of monument for corner and accessories established to perpetuate locating the position of the corner:

02/23/1996 Hoben 35994 O.H.M. Remon

- SET W.C. REMON CAP OVER FD. 1 1/2" I.P.
- 9 MBT POLE S SIDE S 60 E 48.84'
- 10 MBT MARKER S 08 W 18.16'
- 11 Fd. NAIL IN E SIDE OF FOUR 6" TREES S 15 W 25.60'
- 12 Fd. NAIL N SIDE OF FIVE 6" TREES S 50 W 38.10'
- 13 Fd. NAIL W SIDE 10" TREE DUE NORTH 46.30'

SURVEY & REMONUMENTATION

MAY 05 1997

COMMISSION

We conclude that after careful study of the record documentation and field observations, that this corner is accepted as the best available evidence of the position of the original corner.


Signed by Michael S. Hoben Date 11-26-96

Drafted by Michael S. Hoben

Surveyor's Michigan License No. 35994

Orchard, Hiltz and McCliment, Inc. 34935 Schoolcraft Road Livonia, MI 48150

COPY

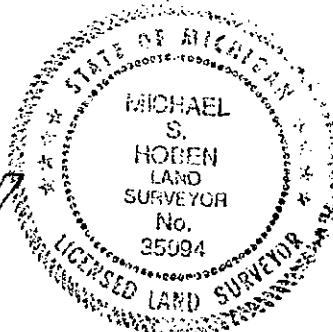

A. (Continued) Description of original monument and accessories and/or subsequent restorations:

- |            |                                  |       |                   |
|------------|----------------------------------|-------|-------------------|
| 05/22/1936 | Armstrong                        |       |                   |
| 1          | 6" ELM N 49 E 38.9'              |       | 1-1/2" x 36" i.p. |
| 2          | 6" MAPLE S 78 E 97.1'            |       |                   |
| 3          | 4" ELM S 75 E 75'                |       |                   |
| 4          | 3" ELM S 68 E 57.2'              |       |                   |
| 5          | 5" ELM S 62 E 42.4'              |       |                   |
| 6          | 36" ELM N 57 W 58.8'             |       |                   |
| 01/07/1974 | Pitts                            | 10702 |                   |
| 7          | 5/8" REROD N 33.00'              |       | Fd. spike         |
| 8          | CUT "X" IN CONC. DRIVE NE 35.67' |       |                   |
| 9          | M.B.T. POLE SE 48.84'            |       |                   |
| 10         | U.G. MARK (M.B.T.) S. 18.16'     |       |                   |
| 01/07/1977 | Burris                           | 19563 |                   |
|            | SAME AS ABOVE                    |       | 1 1/2" iron rod   |
| 01/01/1980 | Roskelly                         | 18663 |                   |
|            | DIST TO J-12 = 2644.24' (M)      |       | l.p.              |
|            | ANGLE N 00-25'45" E              |       |                   |

Y4400