

SURVEY & REMONUMENTATION

- Copy -

MAY 09 1996

LAND CORNER RECORDATION CERTIFICATE

Filing Requirement of Act 74, Mich. P.A. 1970

K-13 Page 1

COMMISSION

For corners in Washtenaw
Wayne

Located in: YPSILANTI Corner Code

1. Public Land Survey		T <u>3</u> S <u>7</u> R <u>7</u> E	<u>K-13</u>
		T _____ R _____	_____
		T _____ R _____	_____
		T _____ R _____	_____
2. Property Controlling in Section	S _____	T _____ R _____	_____
	S _____	T _____ R _____	_____
3. Miscellaneous Property in Sec.	S _____	T _____ R _____	_____
	S _____	T _____ R _____	_____

Register of Deeds Stamp and File Number

4. Lot No. _____, Recorded Plat _____
5. Private Claims _____

	A	B	C	D	E	F	G	H	I	J	K	L	M
2	6	5	4	3	2	1							
3													
4	7	8	9	10	11	12							
5													
6	18	17	16	15	14	13							
7													
8	19	20	21	22	23	24							
9													
10	30	29	28	27	26	25							
11													
12	31	32	33	34	35	36							
13													

I, Michael S. Hoben in a field survey on 03/01/1995 do hereby certify that under requirements of P.A. 74, Michigan P.A. of 1970, the corner points mentioned in lines 1 and 2 above were in conformance with regulations and rules therefore as required in the current manual of survey instructions of the United States Department of the Interior, Bureau of Land Management, or by a decree of a Court of Law and/or that the corner points mentioned in lines 3, 4 and 5 above were in conformance with the rules of the Michigan Board of Land Surveyors or by a Decree of a Court of Law, established, re-established, monumented, re-monumented, recovered, found as expressed below.

NOTE: Not more than 4 corners, all in the same town and range, may be recorded on this certificate.

A. Description of original monument and accessories and/or subsequent restorations:

- 11/23/1816 G.L.O. POST
 1 12" ASH N. 19 LINKS W. 19 LINKS
 2 9" SUGAR S. 15 LINKS E. 19 LINKS

(Witnesses Continued on Back ...)


B. Description of corner evidence found and/or method applied in restoring or reestablishing corner:

1" IRON IN HOLE IN ASPH RD.

C. Description of monument for corner and accessories established to perpetuate locating the position of the corner:

03/01/1995 Hoben 35994 OHM REMON

- 8 TAG IN 36" OAK N 40 W 63.30'
- 9 TAG IN FENCE POST N 43 E 45.68'
- 17 TAG IN 30" OAK N 30 W 74.80'
- 18 GAS MARKER S 35 E 32.50'
- 19 FD. IRON W 242.65'

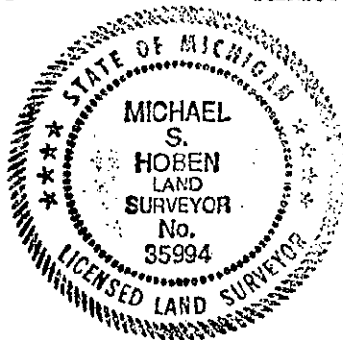

RECORDED
 WASHTEENAW COUNTY, MI
 MAR 29 1 46 PM '96
 PEGGY J. JAMES
 COUNTY CLERK / REGISTER
- Copy -

We conclude that after careful study of the record documentation and field observations, that this corner is accepted as the best available evidence of the position of the original corner.

Signed by *Michael S. Hoben* Date 12-18-95

Drafted by Michael S. Hoben
 Surveyor's Michigan License No. 35994

Orchard, Hiltz and McCliment, Inc. 34935 Schoolcraft Road Livonia, MI 48150

APPROVED
 DATE _____
 CO. REP. _____

- Copy -
K-13 Page 2

A. (Continued) Description of original monument and accessories and/or subsequent restorations:

10/12/1932	BARNES, BETHKE		ATWELL- HICKS,		FD. A POINTED STONE AND WOOD STAKE SET BY S. PETTIBONE. RESET W/ A 2" X 42" I.P. W/ 4 BRICKS AROUND IT.
	3 20" ELM N. 72 W. 70.13'				
	4 12" Y. OAK N. 2 W. 74.8'				
	5 16" W. CHERRY N. 116.17'				
	6 3 R. OF W. PIPES				
12/21/1976	R. BURRIS SR.	19563		L. 4 P	FD. 1/2" RE-ROD
	7 NAIL IN 28" OAK N. 30 W. 73.90'				
	8 NAIL IN 30" OAK N. 40 W. 63.50'				
	9 NAIL IN FENCE COR. POST N. 43 E. 45.85'				
05/26/1977	ROSKELLY	18663	ROSKELLY, JEKABSON		FOUND 3/4" PIPE
	10 SAME AS ABOVE				
	13 NAIL IN 18" ASH N. 40 W. 63.43'				
04/14/1978	N. FAHRNER	17620		L. 5 P	1/2" IRON PIPE
	8 22" ASH N. 30 W. 63.5'				
	9 END FENCE POST N. 45 E. 45.9'				
	11 24" Y. OAK N. 30 W. 34.9' TO NAIL				
	12 3 R/W IRONS				
	14 STOP SIGN N. 55 E. 42.0'				
	15 CENTER MBT. BOX N. 30 E. 81.7'				
05/07/1980	SCHWIMMER	24618	ATWELL- HICKS		1/2" IRON PIPE
	16 SAME AS ABOVE				
06/29/1983	ROBERT S. ?	27453	ATWELL- HICKS		1/2" IRON PIPE
	8 22" ASH N. 30 W. 63.5'				
	9 END FENCE POST N. 45 E. 45.9'				
	14 STOP SIGN N. 55 E. 42.0'				
	15 CENTER MBT. BOX N. 40 W. 58.5'				
	17 24" YELLOW OAK N. 30 W. 74.9'				

APPROVED
DATE 10/16/95
CO. REP. RJ