

- Copy -

SURVEY & REMONUMENTATION

LAND CORNER RECORDATION CERTIFICATE

MAY 09 1996

Filing Requirement of Act 74, Mich. P.A. 1970

L-11 Page 1

For commission

Wayne

Located in:

Corner Code

County

YPSILANTI

1. Public Land Survey

T 3 S R 7 E

L-11

2. Property Controlling in Section

S

T R

3. Miscellaneous Property in Sec.

S

T R

4. Lot No. , Recorded Plat

5. Private Claims

Register of Deeds Stamp and File Number

A B C D E F G H I J K L M

2	6	5	4	3	2	1								
3														
4	7	8	9	10	11	12								
5														
6	18	17	16	15	14	13								
7														
8	19	20	21	22	23	24								
9														
10	30	29	28	27	26	25								
11														
12	31	32	33	34	35	36								
13														

I, Michael S. Hoben in a field survey on 03/01/1995 do hereby certify that under requirements of P.A. 74, Michigan P.A. of 1970, the corner points mentioned in lines 1 and 2 above were in conformance with regulations and rules therefore as required in the current manual of survey instructions of the United States Department of the Interior, Bureau of Land Management, or by a decree of a Court of Law and/or that the corner points mentioned in lines 3, 4 and 5 above were in conformance with the rules of the Michigan Board of Land Surveyors or by a Decree of a Court of Law, established, re-established, monumented, re-monumented, recovered, found as expressed below.

NOTE: Not more than 4 corners, all in the same town and range, may be recorded on this certificate.

A. Description of original monument and accessories and/or subsequent restorations:

11/24/1816

G.L.O.

SET POST

1 9" B. OAK S. 70 LINKS E. 5 LINKS

2 5" ASH S. 80 LINKS W. 11 LINKS

(Witnesses Continued on Back ...)

B. Description of corner evidence found and/or method applied in restoring or reestablishing corner:

FD. MON IN MON BOX IN ASPHALT RD.

C. Description of monument for corner and accessories established to perpetuate locating the position of the corner:

03/01/1995

Hoben

35994

OHM


REMON

3 R.R. SPIKE IN 24" WALNUT N 10 E 118.15'

7 C.L. CONC.GAS MARKER S 45 E 28.40'

18 SET TAG IN 30" TREE N 88 E 45.20'

19 SET TAG IN DE POLE S 20 W 90.16'

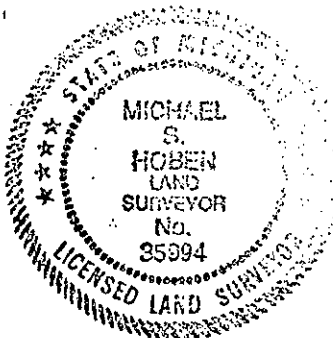

- Copy -

RECORDER  
COUNTY CLERK/REGISTRAR

MAR 29 1 47 PM '96

RECORDED  
WASHTENAW COUNTY, MI

We conclude that after careful study of the record documentation and field observations, that this corner is accepted as the best available evidence of the position of the original corner.

Signed by Michael S. Hoben

Date 12-18-95

Drafted by Michael S. Hoben

Surveyor's Michigan License No. 35994

Orchard, Hiltz and McCliment, Inc. 34935 Schoolcraft Road Livonia, MI 48150

APPROVED

DATE \_\_\_\_\_

CO. REP. \_\_\_\_\_

- Copy -

## A. (Continued) Description of original monument and accessories and/or subsequent restorations:

06/30/1938	ARMSTRONG	W.C.R.	FD I.P. W/ STONES AROUND IT
3	6" ELM N. 15 E. 118.8'		
4	12' THORNAPPLE S. 5 E. 201.8'		
5	10" ELM N. 89 W. 66.9'		
6	10" ELM N. 86.5 W. 45.1'		
09/07/1976		ROSKELLY, JEKABSON	FD. 3/4" IRON PIPE
3	NAIL IN 24" ASH N. 20 E. 118.20'		
7	PIPELINE MARKER S. 60 E. 27.94'		
8	NAIL IN 12' COTTONWOOD S. 30 W. 51.30'		
09/27/1976		ROSKELLY, JEKABSON	FD. 3/4" IRON PIPE
9	SAME AS ABOVE		
03/27/1979		METRO ENGINEERS	N. 1/4 COR.
3	R.R. SPIKE IN 24" WALNUT N. 10 E. 118.35'		
7	TOP CONC. GAS MARKER S. 45 E. 27.92'		
8	NAIL IN 12" POPLAR S. 30 W. 51.3'		
10	CHISEL "X" TOP OF GAS VENT S. 80 W. 31.71'		
05/15/1990	BLANCHARD	27446	NONE
11	DIST. BETWEEN L-11 & M-11 = 2657.67'		
12	DIST. BETWEEN L-11 & L-12 = 2633.45'		
13	INTERIOR ANGEL = 90 35' 43"		
02/14/1992	BLANCHARD	27446 E.P. KUBISKE	
14	DIST. BETWEEN L-11 & L-12 = 2534.00'		
15	DIST. BETWEEN L-11 & K-11 = 2619.70'		
02/10/1994	BLANCHARD	27446 E.P. KUBISKE	
16	DIST. BETWEEN L-11 & M-11 = 2658.80'		
17	DIST. BETWEEN L-11 & L-10 = 2649.49'		

APPROVED  
DATE 10/16/95  
BY [Signature]