

- Copy -

MAY 09 1995

LAND CORNER RECORDATION CERTIFICATE

Filing Requirement of Act 74, Mich. P.A. 1970

L-13 Page 1

COMMISSION

For corners in

Wayne

Located in:

Corner Code

YPSILANTI

L-13

1. Public Land Survey

T 3 S R 7 E

T R

T R

T R

2. Property Controlling in Section

S

T R

S

T R

3. Miscellaneous Property in Sec.

S

T R

S

T R

Register of Deeds Stamp and File Number

4. Lot No. _____, Recorded Plat _____

5. Private Claims _____

A B C D E F G H I J K L M

2	6	5	4	3	2	1								
3														
4	7	8	9	10	11	12								
5														
6	18	17	16	15	14	13								
7														
8	19	20	21	22	23	24								
9														
10	30	29	28	27	26	25								
11														
12	31	32	33	34	35	36								
13														

I, Michael S. Hoben in a field survey on 03/01/1995 do hereby certify that under requirements of P.A. 74, Michigan P.A. of 1970, the corner points mentioned in lines 1 and 2 above were in conformance with regulations and rules therefore as required in the current manual of survey instructions of the United States Department of the Interior, Bureau of Land Management, or by a decree of a Court of Law and/or that the corner points mentioned in lines 3, 4 and 5 above were in conformance with the rules of the Michigan Board of Land Surveyors or by a Decree of a Court of Law, established, re-established, monumented, re-monumented, recovered, found as expressed below.

NOTE: Not more than 4 corners, all in the same town and range, may be recorded on this certificate.

A. Description of original monument and accessories and/or subsequent restorations:

11/01/1816

G.L.O.

NO RECORD FOUND

03/31/1978

R. JAGOW

6998

ATWELL-HICKS

3/4" IRON PIPE

3 24" BURR OAK N'LY 22.5'

REGISTER OF DEEDS
COUNTY OF WAYNE
- COPY -

RECORDED
MAR 29 1 47 PM '96

(Witnesses Continued on Back ...)

B. Description of corner evidence found and/or method applied in restoring or reestablishing corner:

FD. 1" IRON

C. Description of monument for corner and accessories established to perpetuate locating the position of the corner:

03/01/1995

Hoben

35994

OHM


REMON

3 BURR TREE N 10 W 22.50'

4 36" FORKED BURR N 15 W 37.20'

8 3/4" IRON S 2.80'

14 FENCE POST N 30.50'

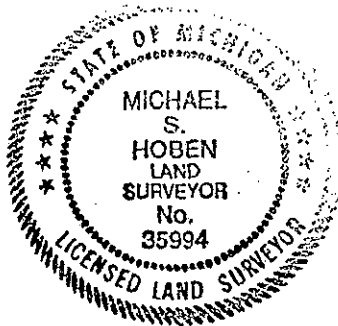

We conclude that after careful study of the record documentation and field observations, that this corner is accepted as the best available evidence of the position of the original corner.

Signed by Michael S. Hoben

Date 12-18-95

Drafted by Michael S. Hoben

Surveyor's Michigan License No. 35994

Orchard, Hiltz and McCliment, Inc. 34935 Schoolcraft Road Livonia, MI 48150

