

- Copy -

MAY 09 1996

LAND CORNER RECORDATION CERTIFICATE

Filing Requirement of Act 74, Mich. P.A. 1970

M-11 Page 1

For corners in Washtenaw County

Located in: YPSILANTI Corner Code

1. Public Land Survey		T 3 S R 7 E	M-11
		T _____ R _____	_____
		T _____ R _____	_____
		T _____ R _____	_____
2. Property Controlling in Section	S _____	T _____ R _____	_____
	S _____	T _____ R _____	_____
3. Miscellaneous Property in Sec.	S _____	T _____ R _____	_____
	S _____	T _____ R _____	_____

Register of Deeds Stamp and File Number

4. Lot No. _____, Recorded Plat _____
5. Private Claims _____

A	B	C	D	E	F	G	H	I	J	K	L	M
2	6	5	4	3	2	1						
3												
4	7	8	9	10	11	12						
5												
6	18	17	16	15	14	13						
7												
8	19	20	21	22	23	24						
9												
10	30	29	28	27	26	25						
11												
12	31	32	33	34	35	36						
13												

I, Michael S. Hoben in a field survey on 03/01/1995 do hereby certify that under requirements of P.A. 74, Michigan P.A. of 1970, the corner points mentioned in lines 1 and 2 above were in conformance with regulations and rules therefore as required in the current manual of survey instructions of the United States Department of the Interior, Bureau of Land Management, or by a decree of a Court of Law and/or that the corner points mentioned in lines 3, 4 and 5 above were in conformance with the rules of the Michigan Board of Land Surveyors or by a Decree of a Court of Law, established, re-established, monumented, re-monumented, recovered, found as expressed below.

NOTE: Not more than 4 corners, all in the same town and range, may be recorded on this certificate.

A. Description of original monument and accessories and/or subsequent restorations:

- 11/24/1816 G.L.O. POST
- 1 18" BIRCH N. 48 LINKS W. 11 LINKS
- 2 12" SUGAR S. 67 LINKS E. 10 LINKS

(Witnesses Continued on Back ...)


B. Description of corner evidence found and/or method applied in restoring or reestablishing corner:

FD. MON IN MON BOX IN ASPHALT RD.

C. Description of monument for corner and accessories established to perpetuate locating the position of the corner:

03/01/1995 Hoben 35994 OHM REMON

- 10 FD P.K. & TAG IN DE POLE N 45 E 78.53'
- 11 19" MAPLE SET TAG N 85 E 64.85'
- 12 TOP OF WOLV. P.L. MARKER S 50 W 42.60'
- 13 FD PK IN MBT POLE N 40 W 47.03'
- 17 SET TAG IN 15" MAPLE S 60 E 75.70'

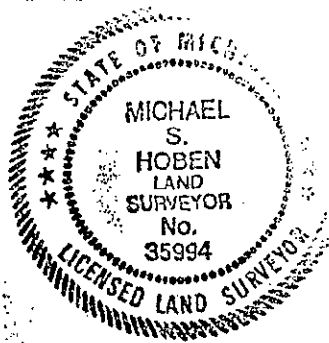

We conclude that after careful study of the record documentation and field observations, that this corner is accepted as the best available evidence of the position of the original corner.

Signed by Michael S. Hoben Date 12-18-95
Drafted by Michael S. Hoben
Surveyor's Michigan License No. 35994

Orchard, Hiltz and McCliment, Inc. 34935 Schoolcraft Road Livonia, MI 48150

RECORDED
WASHTENAW COUNTY, MI
MAR 29 1 49 PM '96
PEGGY A. JAMES
COUNTY CLERK/REGISTER
- Copy -

A. (Continued) Description of original monument and accessories and/or subsequent restorations:

- | | | | | |
|------------|--|----------|--------|---|
| 12/03/1936 | ARMSTRONG,
GRAF | | | FD STONE AND STAKE. SET
I.P., STONES, AND BRICK. |
| 3 | 2" B. CHERRY N. 43 E. 56.1' | | | |
| 4 | 2" B. CHERRY S. 88 E. 39.0' | | | |
| 5 | 3" B. CHERRY S. 51 E. 47.0' | | | |
| 6 | 1" ELM S. 12 E. 140.3' | | | |
| 7 | 4" LOCUST N. 61 W. 35.2' | | | |
| 8 | COR. SEC. 30 & 31 VANBUREN TWP. STANDS N. 63.8' | | | |
| 01/27/1980 | | W.C.R.C. | | |
| 9 | 2646.7' BETWEEN M-11 & M-10 | | | |
| 07/17/1986 | R. PITTS | 10702 | L. 7 P | FOUND 1/2" IRON PIN |
| 10 | NAIL W.W.C.R.C. TAG SE. SIDE DE. POLE NE. 78.53' | | | |
| 11 | P.K. IN ROOT NW. SIDE 19" MAPLE E. 64.85' | | | |
| 12 | TOP OF WOLVERINE PIPELINE MARKER SW. 42.65' | | | |
| 13 | P.K. NE. SIDE M.B.T. POLE NW. 47.03' | | | |
| 05/15/1990 | BLANCHARD | 27446 | | |
| 14 | DIST. BETWEEN M-11 & M-12 = 2651.03' | | | |
| 15 | DIST. BETWEEN M-11 & L-11 = 2657.677' | | | |
| 16 | INTERIOR ANGLE = 89 26' 10" | | | |

APPROVED
 DATE 12/14/95
 PER. [Signature]