

MAY - 1 1995

COMMISSION

COPY

LAND CORNER RECORDATION CERTIFICATE
Filing Requirement of Act 74, Mich. P.A. 1970

LIBER

1 PAGE 201 Rm

- Copy -

For corners in

Washtenaw (County)	Located In:	Corner Code #
1. Public Land Survey	T 4S R 3E	K-10
	T R	
	T R	
	T R	
2. Property Controlling in Section	S T R	
	S T R	
3. Miscellaneous Property in Sec.	S T R	
	S T R	

REGISTERED
 WASHTENAW COUNTY, MI
 DEC 1 11 38 AM '94
 PEGGY H. HAINES
 COUNTY CLERK/REGISTER

Register of Deeds Stamp & File Number

- 4. Lot No. _____, Recorded Plat _____
- 5. Private Claims _____

	A	B	C	D	E	F	G	H	I	J	K	L	M
2	6		5		4		3		2		1		
3													
4	7		8		9		10		11		12		
5													
6	18		17		16		15		14		13		
7													
8	19		20		21		22		23		24		
9													
10	30		29		28		27		26		25		
11													
12	31		32		33		34		35		36		
13													

I, Patrick L. Hastings in a field survey on October 7, 19 94, do hereby certify that under requirements of P.A. 74, Michigan P.A. of 1970, the corner points mentioned in lines 1 and 2 above were in conformance with regulations and rules therefore as required in the current manual of survey instructions of the United States Department of the Interior, Bureau of Land Management or by a decree of a Court of Law and/or that the corner points mentioned in lines 3, 4 and 5 above were in conformance with the rules of the Michigan Board of Land Surveyors or by a Decree of a Court of Law; established, re-established, monumented, re-monumented, recovered, found as expressed below:

NOTE: Not more than 4 corners, all in the same town and range, may be recorded on this certificate.

A. Description of original monument and accessories and/or subsequent restoration:

1816	Subdivision of Township				
	(1) Hickory	6"	S 2° W	27 lks	
	(2) Hickory	5"	N 5° E	29 lks	
1824	Township GLO Plat by John M. Mack				
1930s	W.C.R.C. Grid Book				
	(1) Hickory	6"	S 2° W	27 lks = 17.8	
	(2) Hickory	5"	N 5° E	29 lks = 19.1	

CONTINUED ON BACK


B. Description of corner evidence found and/or method applied in restoring or reestablishing corner:

1994	Found 3/4" x 48" iron pipe cap E.S.P. #12030, 1' above ground and on north side of fence post to south, now fell over, and a fence line to the west.				
	(3) N 45° W	29.03'	22" Maple	No Nail	
	(4) N 75° W	56.67'	18" Maple	No Nail	
	(5) S 65° W	32.43'	13" Maple	Found Nail	
	(6) N 35° W	31.59'	28" Oak	Nail grown over N.S. fence	
	(7) West	11.0'	Fence Post,	fence to north	

C. Description of monument for corner and accessories established to perpetuate locating the position of the corner:

After a careful study of the record documentation and field observations, made under my direct supervision, I find this corner monument to be the best available evidence of the position of the original corner.

CONTINUED ON BACK

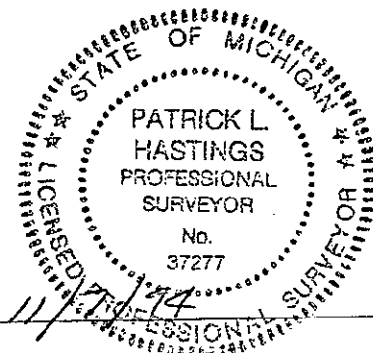

Signed by Patrick L. Hastings Date 11/1/94
 Surveyor's Michigan License No. 37277

1

SECTION 'A' CONTINUED

1974 Witnesses from Associated Engineers and Surveyors, Adrian. Set iron on north side fence post - fence to south.

(3)	N 45° W	29.03'	16" Maple, Nail & disc., S. side
(4)	N 75° W	56.67'	16" Maple, Nail & disc., S. side
(5)	S 65° W	32.43'	12" Maple, Nail & disc., N. side
(6)	N 35° W	31.59'	24" Oak, Nail & disc., E. side
(7)	West	11.0'	Fence to north

1974 Survey by Werner Sommer, Iron Pipe

(3)	N 45° W	29.03'	16" Maple, Nail & disc., S. side
(5)	S 65° W	32.43'	12" Maple, Nail & disc., N. side
(6)	N 35° W	31.59'	24" Oak, Nail & disc., E. side

1974 L.C.R.C. by Werner Sommer, set iron on north side of corner post at intersection of fences.

(3)	N 45° W	29.03'	16" Maple, Nail & disc., S. side
(4)	N 75° W	56.67'	16" Maple, Nail & disc., S. side
(5)	S 65° W	32.43'	12" Maple, Nail & disc., N. side
(6)	N 35° W	31.59'	24" Oak, Nail & disc., E. side

1978 Survey by Werner Sommer

(3)	N 45° W	29.03'	16" Maple, Nail & disc., S. side
(5)	S 65° W	32.43'	12" Maple, Nail & disc., N. side
(6)	N 35° W	31.59'	24" Oak, Nail & disc., E. side

SECTION 'C' CONTINUED

Removed 3/4" x 48" and set 1" x 24" iron pipe and standard remonumentation cap stamped #37277.

(3)	N 45° W	29.03'	16" Maple	RT & PK
(4)	N 75° W	56.67'	16" Maple	RT & PK
(5)	S 65° W	32.43'	12" Maple	RT & PK
(6)	N 35° W	31.59'	24" Oak	RT & PK
(7)	West	11.0'	Fence Post,	fence to north

APPROVED

DATE 11/17/94CO. REP. 14A

7