

- Copy -

COPY

MAY - 1 1995

COMMISSION

LAND CORNER RECORDATION CERTIFICATE
Filing Requirement of Act 74, Mich. P.A. 1970

For corners in

Washtenaw (County)	Located In:	Corner Code #
1. Public Land Survey	T <u>4S</u> R <u>3E</u>	<u>L-9</u>
	T _____ R _____	_____
	T _____ R _____	_____
	T _____ R _____	_____
2. Property Controlling in Section	S _____ T _____ R _____	_____
	S _____ T _____ R _____	_____
3. Miscellaneous Property in Sec.	S _____ T _____ R _____	_____
	S _____ T _____ R _____	_____

- COPY -
PEGGY M. MAINES
COUNTY CLERK/REGISTER

Dec 1 11 39 AM '94

RECORDED
WASHTENAW COUNTY, MI

Register of Deeds Stamp & File Number

- 4. Lot No. _____, Recorded Plat _____
- 5. Private Claims _____

I, Patrick L. Hastings in a field survey on October 7, 19 94, do hereby certify that under requirements of P.A. 74, Michigan P.A. of 1970, the corner points mentioned in lines 1 and 2 above were in conformance with regulations and rules therefore as required in the current manual of survey instructions of the United States Department of the Interior, Bureau of Land Management or by a decree of a Court of Law and/or that the corner points mentioned in lines 3, 4 and 5 above were in conformance with the rules of the Michigan Board of Land Surveyors or by a Decree of a Court of Law; established, re-established, monumented, re-monumented, recovered, found as expressed below:

NOTE: Not more than 4 corners, all in the same town and range, may be recorded on this certificate.

	A	B	C	D	E	F	G	H	I	J	K	L	M
2	6	5	4	3	2	1							
3													
4	7	8	9	10	11	12							
5													
6	18	17	16	15	14	13							
7													
8	19	20	21	22	23	24							
9													
10	30	29	28	27	26	25							
11													
12	31	32	33	34	35	36							
13													

A. Description of original monument and accessories and/or subsequent restoration:

- 1815 Township Boundary Set Post, Hough, P.S.
(1) W. Oak - 8" N 60° E 48 lks
(2) W. Oak - 9" S 82° W 33 lks
- 1816 Subdivision of Township
- 1824 Township GLO Plat by John M. Mack, P.S.
- 1934 W.C.R.C. Grid Book, by W.J. Armstrong. Found a very old wood stake. Reset with a 1 1/2" x 42" iron pipe, stones and bricks.

CONTINUED ON BACK


B. Description of corner evidence found and/or method applied in restoring or reestablishing corner:

- 1994 Found 1 1/4" x 36" iron pipe and brick situated along traveled centerline of E-W road and centerline of road to south. There is an occupational fence line to the north.
(3) N 06° W 27.60' U.S.G.S. BM #30-1929
(5) N 85° E 102.40' 16" Hickory nail & tag
(6) N 75° E 85.02' 16" Hickory no nail & tag
(7) S 76° E 119.40' 18' Walnut no nail & tag

C. Description of monument for corner and accessories established to perpetuate locating the position of the corner:

After a careful study of the record documentation and field observations, made under my direct supervision, I find this corner to be a careful and faithful perpetuation of the position of the original corner.

CONTINUED ON BACK

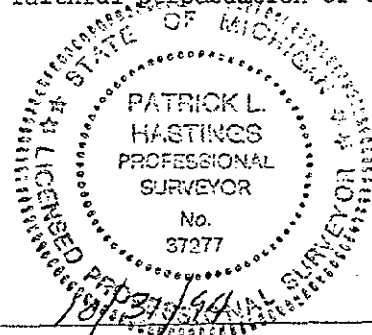

Signed by Patrick L. Hastings Date _____
Surveyor's Michigan License No. 37277

SECTION 'A' CONTINUED

1934	Typed			
	(3)	N 6° W	27.6'	U.S.G.S.B.M. (TT30, 1929)
	(4)	N 71 1/2° E	69.3'	3" Hickory
	(5)	N 75° E	102.4'	5" Hickory
	(6)	N 73 1/2° E	84.8'	5" Hickory
	(7)	S 76° E	119.4'	8" Walnut
	(8)	S 63° E	60.6'	12" Hickory
	(9)	S 79° W	115.6'	6" Butternut
	(10)	North	33.0'	R/W Iron
	(11)	S.E.		R/W Iron
	(12)	S.W.		R/W Iron
	Handwritten			
	(6)	N 74° E	84.94'	8" Hickory
	(8)	S 70° E	60.78'	16" Hickory
no date	(13)	S 43° W	47.04'	Cor. Fe. Post
1942	W.C.R.C. Grid Book Plat by W.J. Armstrong			
	East		2730.0'	N.E. Cor. of Section
	West		2707.0'	N.W. Cor. of Section
1971	Survey by John L. Snyder			
	(3)	N 6° W	27.6'	U.S.G.S.B.M., TT30, 1929
	(5)	N 75° E	102.4'	12" Hickory
	(6)	N 75° E	84.8'	12" Hickory
	(7)	S 76° E	119.4'	12" Walnut
1974	From Associated Engineers & Surveyors Adrian. Found 1 1/2" Iron			
	(3)	N 06° W	27.60'	U.S.G.S.B.M., TT30, 1929
	(5)	N 85° E	102.40'	14" Hickory Nail & disk S. side
	(6)	N 75° E	85.05'	14" Hickory MSHD tag, S. Side
	(7)	S 76° E	119.40'	14" Walnut Nail & disc, N. Side
	(13)	S 45° W	47.15'	Cor. Fe. Post Nail & disc, N. Side
1974	Survey by Werner Sommer. Found 1 1/2" Iron			
	(3)	N 06° W	27.60'	U.S.G.S.B.M., TT30, 1929
	(6)	N 75° E	85.05'	14" Hickory MSHD Tag S. Side
	(7)	S 76° E	119.40'	14" Walnut Nail & disc, N. Side
1978	Survey by Werner Sommer.			
	(3)	N 06° W	27.60'	U.S.G.S.B.M., TT30, 1929
	(6)	N 75° E	85.05'	14" Hickory MSHD Tag S. Side
	(7)	S 76° E	119.40'	14" Walnut Nail & disc, N. Side

SECTION 'C' CONTINUED

Reset with 1" x 24" iron pipe, brick and remonumentation cap stamped #37277.

(3)	N 06° W	27.60'	U.S.G.S.B.M., BM #30-1929
(5)	N 85° E	102.40'	16" Hickory RT & PK
(6)	N 75° E	85.02'	16" Hickory RT & PK
(7)	S 76° E	119.40'	18" Walnut RT & PK

APPROVED

DATE 10/31/94CO. REP. K/A